

State Well Report

Part 1 - Driller's Log

Mississippi Department of Environmental Quality
Office of Land and Water Resources
P.O. Box 2309
Jackson, MS 39225
(601)961- 5210
(601)961- 5228 (fax)

County: Marshall
Permit #: _____
Driller: Jones & Mason
Date drilling completed: 3-14-09

For Office Use Only:
Aquifer: _____
Well #: H-348
L. S. Elevation: _____
E-log #: _____

State Law requires that this report be prepared by the license holder responsible for the work and filed with the Department at the above address within 30 days of completion of drilling of the well or borehole.

Information on Well Owner
(Landowner if borehole is not for a water well)

Owner Name: Desoto Builders
Mailing Address: Lot 27
Strickland rd farms
Byhalia MS 38611
City State Zip Code
Telephone No. (601) 497-2482

Well or Borehole Location


Latitude: 34° 49' 54.33" Longitude: 89° 42' 22.14"
Method of Lat/Long (circle one): Conventional Survey, Hand-held GPS
USGS quad. SE 1/4 NE 1/4 Sec 14 Twn 3S Rng 5W
Distance 1 Miles Direction SW of Nearest Town Warsaw

Well / Borehole Data

Date drilling started: 3-14-09 Date drilling completed: 3-14-09 Hole depth: 106' Hole diameter: 6 3/4"
Location of the source of any surface water used for drilling: NA
Method of dosing and volume of Chlorine used in drilling and development: NA
Logs run (circle all applicable): No log run Electric Gamma Ray Density Sonic Neutron Other: _____
Name of organization running log(s): NA
Purpose of borehole (check one): Water Well Geotechnical/Geological Investigation Ground Source Heat Pump
Seismic Survey Other (describe) _____
If drilling is not related to water well construction, skip the remainder of this block

Purpose of Well (check one): Home Industrial Public Supply Irrigation Fish Culture Other: _____
If a flowing well, method of flow regulation: Valve NA Other (describe) _____
Static Water Level: 75 feet above or below (circle one) land surface Date measured: 4-4-09
Method of Measurement (circle one) steel tape electric tape air line other: string height
Well depth: 106 Well grouted to a depth of 10 feet Type of grout (circle one): Neat Cement Bentonite Mix
Casing length: 98 feet Casing diameter: 4 inches Type of casing: pvc
Screen length: 10 feet Screen diameter: 4 inches Type of screen: pvc
Screen slot size: .010 inches Setting depth: From 98 feet to 106 feet
Type of completion (circle all applicable): Gravel packed Underreamed Telescoped Open hole Natural Development
Other (describe): NA
Top of lap pipe or reduction in casing: NA feet. *If telescoped or more than one screen, describe on next page*

Form: OLWR-SWR-1A (04/08)

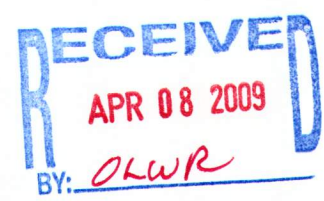

STATE WELL REPORT

Part 2

Pump Installer's Completion Report
 Mississippi Department of Environmental Quality
 Office of Land and Water Resources
 P.O. Box 2309
 Jackson, MS 39225
 (601)961-5210
 (601)961-5228 (fax)

County: Marshall
 Permit #: _____
 Driller: James W. Mason
 Date completed: 4-4-09
Copy information from block on Part 1

For Office Use Only:

Aquifer: _____
 Well #: H-348
 Elevation: _____

This part of the report must be completed by a licensed water well contractor or a licensed pump installer. A copy of Part 1 of the report must be attached and both parts filed with the Department at the above address within 30 days of well completion.

Well Owner Information	Well Location
Owner Name: <u>Desoto Builders</u>	Latitude: <u>34-59-547</u> Longitude: <u>89-42,227</u>
Mailing Address: <u>Lot 27</u>	Method of Lat/Long (check one): Conventional Survey _____
<u>Strickland rd forms</u>	USGS quad _____, Hand-held GPS <input checked="" type="checkbox"/> , Survey-grade GPS _____
<u>Byhalia MS 38611</u>	<u>SE 1/4 NE 1/4 Sec 14 T 3S R 5W</u>
City State Zip Code	Distance Direction Nearest Town
Telephone No. <u>(901) 497-2482</u>	<u>1</u> Miles <u>SW</u> of <u>Warsow</u>

Pump Type Circle one	Power Type Circle one
Air Lift Jet <input type="checkbox"/> <u>Submersible</u> <input checked="" type="checkbox"/>	Diesel Engine Gasoline Engine Natural Gas
Bucket Piston Turbine	<u>Electric Motor</u> <input checked="" type="checkbox"/> Hand Tractor PTO
Centrifugal Rotary Flowing Well	Windmill Other (specify): _____
Other (specify): _____	Horse Power Rating of Motor: <u>1 hp</u>
Date Pump Installed: <u>4-4-09</u>	Setting Depth: <u>100</u> feet
Rated Pump Capacity: <u>10</u> Gallons Per Minute	Number of Stages: <u>8</u>

Pump Test Data	Method of Measuring Water Level Circle one
Date Well Tested: <u>4-4-09</u>	Air Line Electric Measuring Line Steel Tape
Static Water Level (A): <u>75</u> Feet Below Land Surface	Other (specify): <u>string weight</u>
Pumping Water Level (B): <u>NA</u> Feet Below Land Surface	For flowing well, measured shut in head: <u>NA</u> feet
Drawdown [(B) - (A)]: <u>NA</u> Feet Below Land Surface	Well yielded <u>10</u> GPM with a drawdown of
Test Pumping Rate: <u>10</u> Gallons Per Minute	<u>NA</u> feet after <u>24</u> hours of pumping
Duration of Pump Test (minimum 4 hours): <u>24</u> hours	

I HEREBY CERTIFY that the above statements are true to the best of my knowledge.

James W. Mason 0-620 James W. Mason
 Print Name of Pump Installer and License No. (if applicable) Signature of Pump Installer

Form: OLWR-SWR-1B(04/00)

APR 08 2009
 BY: OLWR