	State We	ell Report	For Office Use Only:
		riller's Log	
ounty: Morshall	Morshall Mississippi Department of Environmental Quality		Aquifer: H 358
	Office of Land and	d Water Resources	
ermit #:	P.O. Box 2309		Well #:
ermit#:		MS 39225	
	(601)9	61- 5210	L. S. Elevation:
Date drilling completed: 2-18-10		- 5228 (fax)	E-log #:
State Law requires that this report	be prepared by the lice	nse holder responsible for	the work and filed with the
State Law requires that this report Department at the above address w	vithin 30 days of compl	enon of arming of the week	
Information on Well Ov	vner	wen of D	Di choic Docación
(Landowner if borehole is not for	a water well)	34,49,76	" Langituda: 89.42,085"
wner Name william Por	bor	Latitude: 40	" Longitude: <u>89.42</u> , <u>085</u> , ne): Conventional Survey, 05
		Method of Lat/Long (circle o	ne): Conventional Survey,
lailing Address: 439 Stricklass			d GPS, Survey-grade GPS
		SE 1/4 NW 1/4 Sec	Twn 35 Rng 5W
Byhalia M	5 38611	N	
Byholia <u>Mi</u> City State	Zip Code	Distance Direction	Nearest Town
		112 Miles 5	of warson
elephone No. (901) 482 - 358	L		
	Well / Bore	hole Data	
Date drilling started: $\frac{34840}{24840}$ Date dril			
		4	
Location of the source of any surface water Method of dosing and volume of Chlorine	used in drilling and devel	opment:	
logs run (circle all applicable). No log run Name of organization running log(s):	Electric Gamma Ray	Density Some Neuron	Oulei
Purpose of borehole (check one): Water We	Il Geotechnical/Geol	ogical Investigation Grou	nd Source Heat Pump
Seismic S	urvey Other (describe)_m	
If drilling is not related	to water well constructio	n, skip the remainder of this l	block
	1		
Purpose of Well (check one): Home		IrrigationFish Cultur	Outer
	acA	ther (describe)	
f a flowing well, method of flow regulation			
Static Water Level: 54 feet ab	ove or below (circle one)	and surface Date measured	: 3-10'-10
Method of Measurement (circle one) sto	eel tape electric tape	air line other: 5-	ring I neight
Well depth: (00) Well grouted to a dep			
Casing length: 90 feet Casin			
Screen length: <u>(0</u> feet Screen			
Screen slot size: , OIO inches			
Type of completion (circle all applicable):	Gravel packed Under		en hole Natural Development
		14	
Top of lap pipe or reduction in casing:	feet. If te	elescoped or more than one sc	reen, describe on next page
			Form: OLWR-SWR-1A (04

RECEIVED

MAR 1 8 2010

BY: OLWR




The sketch below only required for water wells

If well telescopes, show depths on sketch. Ground Level_____ Description of formations encountered must be provided for all wells and boreholes, unless specifically exempted by regulations

Description of Formations Encountered	From (depth)	To (depth)
clay dift	Ground Level	10
Led roud	10	30
while sad	30	100

If more than one screen, show location of each on sketch

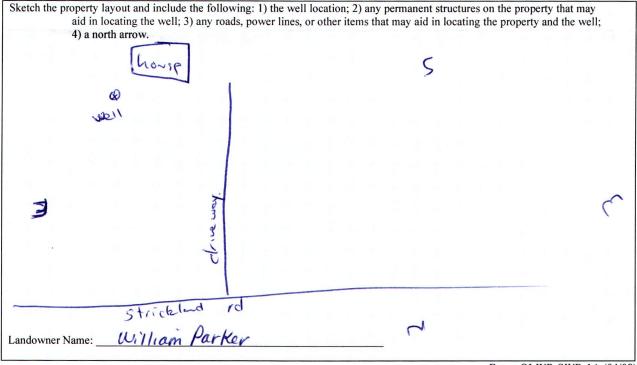

Form: OLWR-SWR-1A (04/08)

I certify that the well/borehole was drilled, constructed, and completed in accordance with all applicable requirements of the Mississippi Department of Environmental Quality and the Mississippi Department of Health regulations, if applicable, and state laws.

0-620 cres w. Me

3-15-10 Date

Print Name of Responsible Licensee and License No.

Signature of Licensee

N

MAR 1 8 2010

	STATE WELL REPORT	
County: <u>Marshall</u> Permit #: Driller: <u>Jaces w. Masc</u> 2 Date completed: <u>A 18-10</u>	Part 2 Pump Installer's Completion Report Mississippi Department of Environmental Quality Office of Land and Water Resources P.O. Box 2309 Jackson, MS 39225 (601)961-5210 (601)961-5228 (fax)	For Office Use Only; Aquifer: H 3 58 Well #: Elevation:
Copy information from block on Part 1	(001)901-3228 (lax)	

This part of the report must be completed by a licensed water well contractor or a licensed pump installer. A copy of Part 1 of the report must be attached and both parts filed with the Department at the above address within 30 days of well completion.				
Well Owner Information	Well Location			
Owner Name: William Parker	Latitude: 34.49.769 Longitude: 89.42.085			

Distance

Method of Lat/Long (check one): Conventional Survey____, USGS quad____, Hand-held GPS___, Survey-grade GPS___

Direction Nearest Town

BY: OLWR

<u>SE 1/ NW 1/ Sec 34 T 35 R 5W</u>

1/2 Miles 5 of worsow

Mailing Address:	439	Strictland	<u>b</u>
_			

Byhalic	2~~>	38611
City	State	Zip Code

Telephone No. (101) 482-3581

Pump Type Circle one		Power Type Circle one			
Air Lift	Jet	Submersible	Diesel Engine	Gasoline Engine	Natural Gas
Bucket	Piston	Turbine	Electric Motor	Hand	Tractor PTO
Centrifugal	Rotary	Flowing Well	Windmill	Other (specify):	
Other (specify):	<u>_</u>		Horse Power Rating	of Motor: 314	,
Date Pump Installed:	2-18	-10	Setting Depth:	70	feet
Rated Pump Capacity:	01	Gallons Per Minute	Number of Stages:	8	

Pump Test Data	Method of Measuring Water Level Circle one	
Date Well Tested: Ə - 18-10		
Static Water Level (A): 54 Feet Below Land Surface	Air Line Electric Measuring Line Steel Tape	
Pumping Water Level (B):Feet Below Land Surface	Other (specify): <u>String / weight</u>	
Drawdown [(B) – (A)]:Feet Below Land Surface	For flowing well, measured shut in head:feet	
Test Pumping Rate: (🗘 Gallons Per Minute	Well yielded GPM with a drawdown of	
Duration of Pump Test (minimum 4 hours): <u> </u>	$\mathcal{M}_{\text{feet after}} \xrightarrow{\partial \mathcal{H}}_{\text{hours of pumping}}$	

I HEREBY CERTIFY that the above statements are true to the best of r	ny knowledge.	
Jones W. Muscu 0-620	Gas w. Man	
Print Name of Pump Installer and License No. (if applicable)	Signature of Pump Installer	
	Form: OLWR-SVID IE 0408	VED
	MAR	2018