,	STATE	WELL REPORT		
County: MACS 1	SIALE	Part 1	For Office Use Only:	
Permit #:		riller's Log	Well #: <u>H37</u>	
Driller: Janes w Mason		ment of Environmental Quality and and Water Resources	Aquifer:	
		P.O. Box 2309	E-Log #:	
Date drilling completed: <u>ראררארין</u>		on, MS 39225-2309 (601)961-5210		
		1)360-0535 (fax)		
State Law requires that this report Department at the above address w				
Well Owner Informat	ion	Well or Borehole Location		
(Landowner if borehole is not for		Latitude: 34 50 36.73 Longitude: 89640 34.55		
Owner Name: <u>Cloyton Hon</u> Mailing Address: <u>183</u> Tunstal		Method of Lat/Long (check one): Conventional Survey		
	1 Daney 1001	USGS quad, Hand-held G	PS, Survey-grade GPS	
<u> </u>		SEN KNE K CM	12 T 35 R 5 W	
$\frac{B_{\text{Nolice}}}{\text{City}} \qquad $	<u>38611</u> Zip Code			
Telephone No. (<u>662</u>) <u>226-079</u>	•	$\frac{314}{(Distance)}$ Miles $\frac{NE}{(Direction)}$ o	(Nearest Town)	
	<u> </u>			
Method of dosing and volume of Chlorin Logs run (circle all applicable): No log r		• •	-	
Name of organization running log(s):	NA			
Purpose of borehole (circle one): Water	Welt> Geotechni	cal/Geological Investigation	Ground Source Heat Pump	
Seism	ic Survey Other (describe)		
If drilling is not rela	ited to water well co	onstruction, skip the remainder	of this block	
Purpose of Well (circle all applicable):	Home Industrial	Public Supply Irrigation	Fish Culture	
Other (describe):				
If a flowing well, method of flow regula	ation: Valve <u>~い</u>	• Other (<i>describe</i>)		
Static Water Level: <u>48</u> feet	[above or below (circle one)	land surface Date measured	1: 9-27-13	
Method of measurement (circle one): S				
Well depth: <u>140</u> Well grouted to a				
Casing length: <u>130</u> feet Ca	sing diameter:	<u> </u>	asing:	
Screen length: <u>10</u> feet S	creen diameter:	inches Type of s	screen:္ပင	
Screen slot size: <u>010</u> inches	Setting depth:	From <u>130</u> feet to	I H Dfeet	
Type of completion (circle all applicable	?): Gravel packed	Underreamed Open hole		
Other (<i>describe</i>):ما بم				
Top of lap pipe or reduction in casing:	μiAfeet			
If telesco	ped or more than a	one screen, describe on next pag	20	

.

Form: OLWR-SWR-1A (4/13)


County:	Marshall	
---------	----------	--

Permit #:

The sketch below only required for water wells

For Office Use Only:

If well telescopes, show depths on sketch.

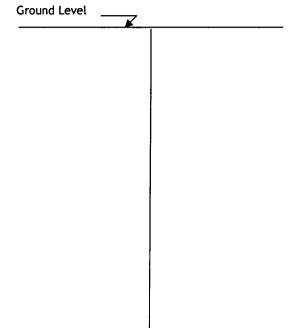

Description of formations encountered must be provided for all wells and boreholes, unless specifically exempted by regulations

Description of Formations Encountered	From (<i>depth</i>)	To (depth)
	Ground level	95
red soud. White soud.	25	140

If more than one screen, show location of each on sketch

Sketch the property layout and include the following:

1) the well location

2) any permanent structures on the property that may aid in locating the well

3) any roads, power lines, or other items that may aid in locating the property and the well

4) north arrow			Trustoll rel	£
	رمدو			
دى	ماادر			
5	ع			
drive	Tourhill			
Jun Marine Stran	4	5		Brank (
Landowner Name: <u>Clarton 1to</u>	nes			
I HEREBY CERTIFY that the well/borehole requirements of the Mississippi Department if applicable, and state laws.	was drilled nt of Enviro	, constructed, and nmental Quality ar	completed in accordance nd the Mississippi Departm	with all applicable ent of Health regulations,
Jones W- Mason 0-62 Print Name of Responsible Licensee and L		10-22-13 Date	Jews w · A Signature	normalization of Licensee

STATE WELL REPORT				
County:	Part 2	For Office Use Only:		
Permit #:	Pump Installer's Completion Report	•		
Driller: James w. Mason	Mississippi Department of Environmental Quality Office of Land and Water Resources	Well #:		
Date completed: $9-27-13$	P.O. Box 2309			
Copy information from block on Part 1	Jackson, MS 39225-2309 (601)961-5210	Aquifer:		
copy information from block on furt f	(601) 360-0535 (fax)			
This part of the report must be completed of the report must be attached and both p	by a licensed water well contractor or a licensed pu arts filed with the Department at the above address	within 30 days of well completion.		
Well Owner Informatio		Location		
Owner Name: <u>Clayton</u> Homes	Latitude: <u>3 4 من من 73</u> Lo	ngitude: <u>89°40'24,55</u>		
Mailing Address: 182 Turestall u	مالحر (تارید Method of Lat/Long (check one	e): Conventional Survey,		
	USGS quad, Hand-held C	GPS, Survey-grade GPS		
Byhalig Ms City State	38611 SW 1/ NE 1/4. Sec	12 T 35 R 5W		
City State				
Telephone No. (662) _ 226 ~ 079	니 (Distance) (Direction)	f <u>Norsow</u> (Nearest Town)		
	Pump Type (circle one)			
Submersible Turbine Air Lift Centrifugal Flowing Well Jet Piston Rotary Other (<i>describe</i>):				
Date Pump Installed: $\frac{9-27-13}{}$ Rated Pump Capacity: <u>10</u> Gallons Per Minute				
		outons i el minuce		
Is This Pump (circle one): New Repa	Power Type (circle one)			
Flectric Diesel Gasoline Natural Gas	Tractor PTO Windmill Other (<i>describe</i>):			
		\circ		
Horse Power Rating of Motor: 314 Setting Depth: 80 feet Number of Stages: $3'$				
	Pump Test Data for Non Flowing Well			
Date Well Tested: <u> </u>	Duration of Pump Test (minin	num 4 hours): <u>24</u> hours		
Static Water Level (A): $\underline{48}$ Feet	Below Land Surface Pumping Water Level (B): _	$\cancel{4}$ Feet Below Land Surface		
Drawdown [(B) - (A)]:F	eet Below Land Surface Test Pumping Rate:	<u>(</u>) Gallons Per Minute		
Method of measurement (circle one): Steel tape Electric tape Air line Other (describe):				
Pump Test Data for Flowing Well				
Measured shut in head: <u>~ (</u>				
Well yielded <u>(</u>) GPM with a dr	awdown of <u>~14</u> feet after <u>24</u>	hours of pumping		
	Meter Installation	×14		
	Meter Serial Number: _			
	14 Type of Meter:			
Totalizer Register Unit and Multiplier Factor (AF x .001, gal x 1000, etc): <u>ا سر</u>				
Installation Date: <u>~/4</u> M	eter installed by: $\sim iA$	· · · · · · · · · · · · · · · · · · ·		
Is This Meter (circle one): New Repaired Replacement				
Important: By submitting the above information you are certifying that this meter was installed to manufacturer standards. For agricultural wells, a list of approved meters is on the MDEQ website.				
I HEREBY CERTIFY that the above statements are true to the best of my knowledge.				
Tares W. Mojer 0-620 (0-32-13) Jesu Man Print Name of Pump Installer and License No. (<i>if applicable</i>) Date Signature of Pump Installer				
Jones W. Moson O.	-620 10.33-13 fersu	S. Mon		

r

•

Form: OLWR-SWR-1B (4/13)