

392

STATE WELL REPORT

Part 1

Driller's Log

Mississippi Department of Environmental Quality
Office of Land and Water Resources
P.O. Box 2309
Jackson, MS 39225-2309
(601)961-5210
(601)360-0535 (fax)

For Office Use Only:

Well #: H392
Aquifer: _____
E-Log #: _____

County: Marshall
 Permit #: _____
 Driller: Jones w. Moran
 Date drilling completed: 9-19-18

State Law requires that this report be prepared by the license holder responsible for the work and filed with the Department at the above address within 30 days of completion of drilling of the well or borehole.

Well Owner Information <i>(Landowner if borehole is not for a water well)</i>	Well or Borehole Location
Owner Name: <u>RS Allen / Dollar General</u>	Latitude: <u>34°47'38.58" N</u> Longitude: <u>89°41'16.76" W</u>
Mailing Address: <u>2945 Hwy 3095</u>	Method of Lat/Long (check one): Conventional Survey _____, USGS quad _____, Hand-held GPS <input checked="" type="checkbox"/> , Survey-grade GPS <input checked="" type="checkbox"/>
<u>Bihalia</u> <u>MS</u> <u>38611</u>	<u>NW</u> $\frac{1}{4}$ <u>SW</u> $\frac{1}{4}$, Sec <u>25</u> T <u>35</u> R <u>5W</u>
City State Zip Code	<u>1 1/2</u> Miles <u>N</u> of <u>Watson</u>
Telephone No. (<u>662</u>) <u>513-4194</u>	(Distance) (Direction) (Nearest Town)

Well / Borehole Data

Date drilling started: 9-19-18 Date drilling completed: 9-19-18 Hole depth: 182' Hole diameter: 9 3/4"

Location of the source of any surface water used for drilling: N/A

Method of dosing and volume of Chlorine used in drilling and development: 50 ppm and greater

Logs run (circle all applicable): No log run Electric Gamma Ray Density Sonic Neutron Other: _____

Name of organization running log(s): N/A

Purpose of borehole (circle one): Water Well Geotechnical/Geological Investigation Ground Source Heat Pump
Seismic Survey Other (describe) Dollar General store

If drilling is not related to water well construction, skip the remainder of this block

Purpose of Well (circle all applicable): Home Industrial Public Supply Irrigation Fish Culture
Other (describe): Dollar General Store Commercial

If a flowing well, method of flow regulation: Valve N/A Other (describe) _____

Static Water Level: 90 feet [above or below land surface] (circle one) Date measured: 9-20-18

Method of measurement (circle one): Steel tape Electric tape Air line Other (describe): string weight

Well depth: 182 Well grouted to a depth of: 120 feet Type of grout (circle one): Neat Cement Bentonite Mix

Casing length: 122 feet Casing diameter: 4 inches Type of casing: pvc

Screen length: 60 feet Screen diameter: 4 inches Type of screen: pvc

Screen slot size: .008 inches Setting depth: From 122 feet to 182 feet

Type of completion (circle all applicable): Gravel packed Underreamed Open hole Natural Development

Other (describe): N/A

Top of lap pipe or reduction in casing: N/A feet

If telescoped or more than one screen, describe on next page

STATE WELL REPORT

Part 2

Pump Installer's Completion Report
 Mississippi Department of Environmental Quality
 Office of Land and Water Resources
 P.O. Box 2309
 Jackson, MS 39225-2309
 (601)961-5210
 (601) 360-0535 (fax)

For Office Use Only:

Well #: 14392
 Aquifer: _____

County: Marshall
 Permit #: _____
 Driller: Jones W. Mason
 Date completed: 9-20-18
Copy information from block on Part 1

This part of the report must be completed by a licensed water well contractor or a licensed pump installer. A copy of Part 1 of the report must be attached and both parts filed with the Department at the above address within 30 days of well completion.

Well Owner Information	Well Location
Owner Name: <u>RJ Allen / Doller General</u>	Latitude: <u>34°47'38.58" N</u> Longitude: <u>89°41'16.76" W</u>
Mailing Address: <u>2945 hwy 3095</u>	Method of Lat/Long (check one): Conventional Survey _____, USGS quad _____, Hand-held GPS <input checked="" type="checkbox"/> , Survey-grade GPS _____
<u>Byhalia</u> <u>MS</u> <u>38611</u>	<u>NW</u> ¼ <u>SW</u> ¼, Sec <u>25</u> T <u>3S</u> R <u>5W</u>
City State Zip Code	<u>1/2</u> Miles <u>N</u> of <u>Watson</u>
Telephone No. (<u>662</u>) <u>513-4194</u>	(Distance) (Direction) (Nearest Town)

Pump Type (circle one)

Submersible Turbine Air Lift Centrifugal Flowing Well Jet Piston Rotary Other (describe): _____

Date Pump Installed: 9-20-18 Rated Pump Capacity: 10 Gallons Per Minute

Is This Pump (circle one): New Repaired Replacement

Power Type (circle one)

Electric Diesel Gasoline Natural Gas Tractor PTO Windmill Other (describe): _____

Horse Power Rating of Motor: 1hp Setting Depth: 120 feet Number of Stages: 15

Pump Test Data for Non Flowing Well

Date Well Tested: 9-20-18 Duration of Pump Test (minimum 4 hours): 24 hours

Static Water Level (A): 90 Feet Below Land Surface Pumping Water Level (B): N/A Feet Below Land Surface

Drawdown [(B) - (A)]: N/A Feet Below Land Surface Test Pumping Rate: 10 Gallons Per Minute

Method of measurement (circle one): Steel tape Electric tape Air line Other (describe): String / weight

Pump Test Data for Flowing Well

Measured shut in head: N/A feet.

Well yielded 10 GPM with a drawdown of N/A feet after 24 hours of pumping

Meter Installation

Meter Manufacturer: N/A Meter Serial Number: N/A

Meter Model Number/Name: N/A Type of Meter: N/A

Totalizer Register Unit and Multiplier Factor (AF x .001, gal x 1000, etc): N/A

Installation Date: N/A Meter installed by: N/A

Is This Meter (circle one): New Repaired Replacement

Important: By submitting the above information you are certifying that this meter was installed to manufacturer standards. For agricultural wells, a list of approved meters is on the MDEQ website.

I HEREBY CERTIFY that the above statements are true to the best of my knowledge.

Jones W. Mason 0-620 10-17-18 Jones W. Mason
 Print Name of Pump Installer and License No. (if applicable) Date Signature of Pump Installer

(OLIVE
BRANCH)




BYHALIA QUADRANGLE
MISSISSIPPI
TOPOGRAPHIC SERIES (MT PLEASANT)

089° 42' 15.3508" W
034° 48' 59.4182" N

(BYHALIA NW)

089° 39' 51.2351" W
034° 48' 59.4182" N

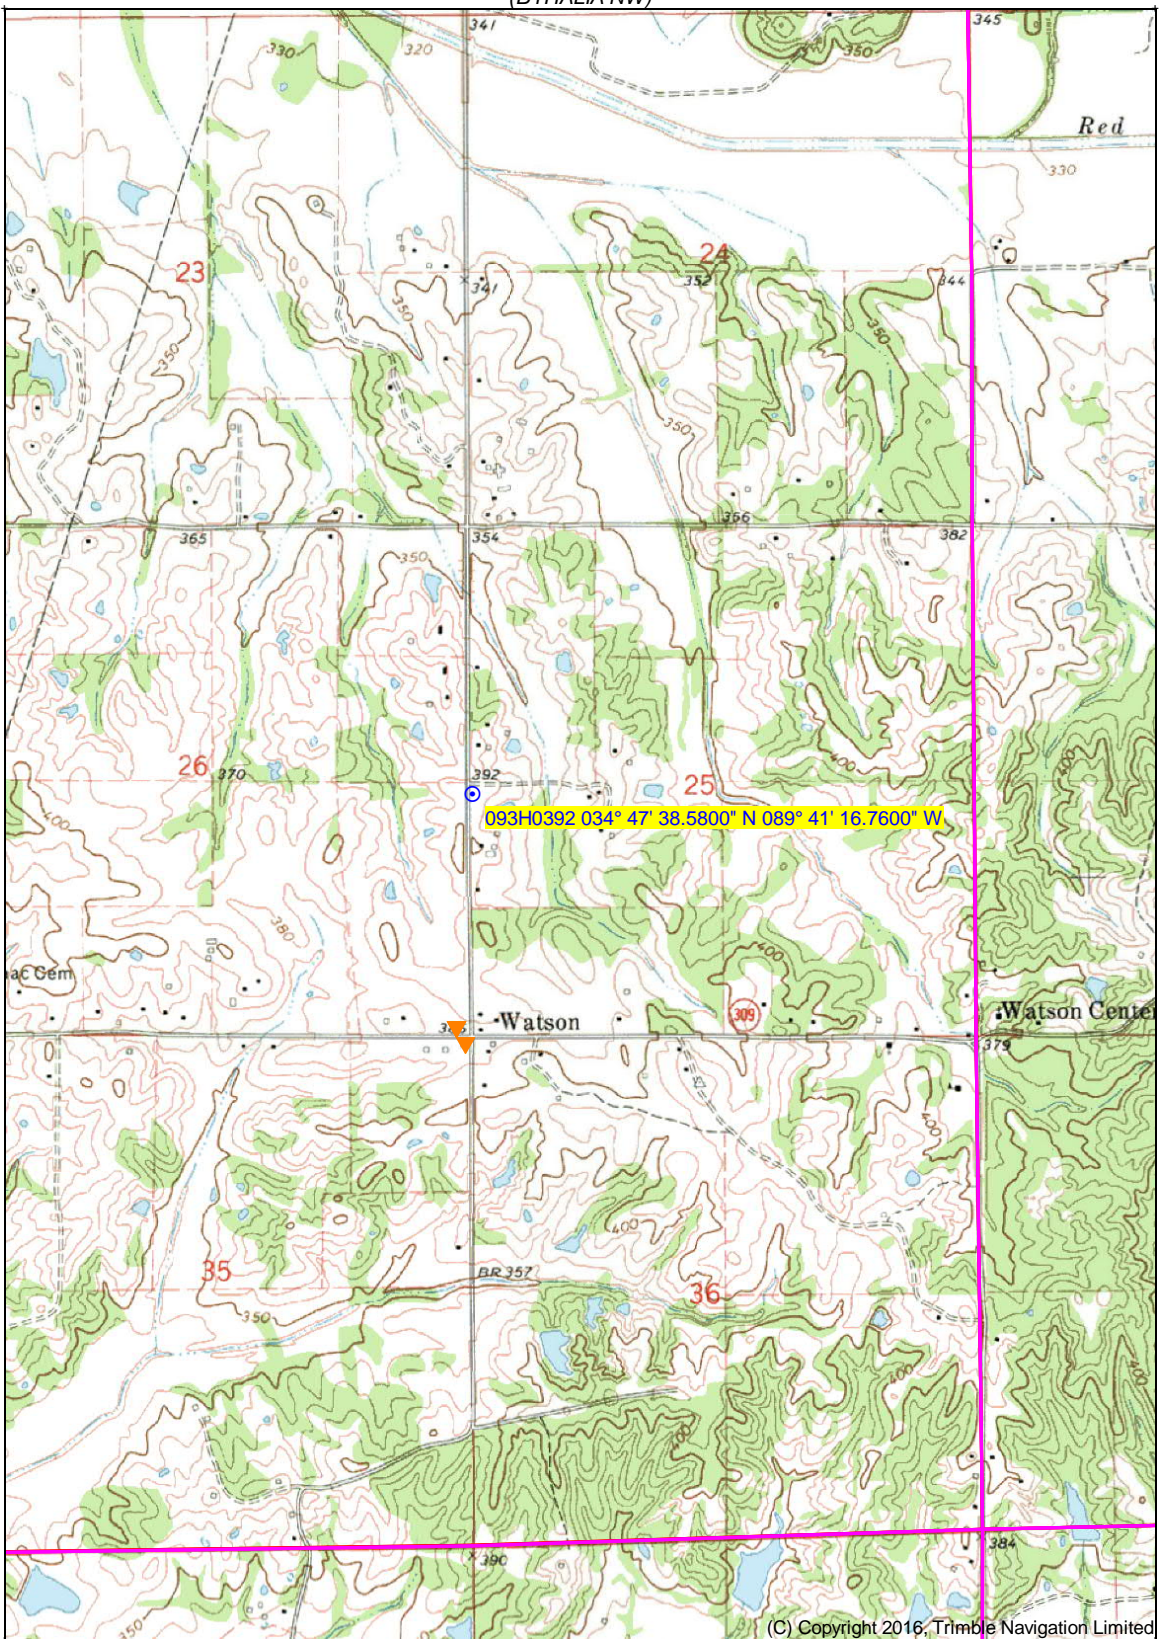

(LEWISBURG)

(RED BANKS)

034° 46' 11.7828" N
089° 42' 15.3508" W

(WYATTE)
SCALE 1:24000

034° 46' 11.7828" N
089° 39' 51.2351" W
Printed: Tue Feb 25, 2020


(INDEPENDENCE)

(MARIANNA)

Produced by Trimble Terrain Navigator Pro
Topography based on USGS 1:24,000
Maps

North American 1983 Datum (NAD83)

To place on the predicted North American
1927 move the projection lines 11M N and
8M W

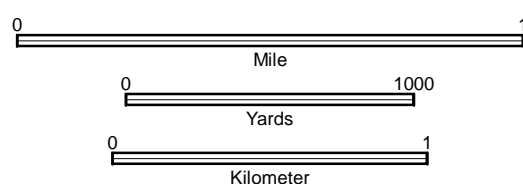

CONTOUR INTERVAL 10 FT

34089-G6-TM-024
BYHALIA, MS
JAN 1, 1971

(C) Copyright 2016, Trimble Navigation Limited