

# STATE WELL REPORT

## Part 1

### Driller's Log

Mississippi Department of Environmental Quality  
 Office of Land and Water Resources  
 P.O. Box 2309  
 Jackson, MS 39225-2309  
 (601)961-5210  
 (601)360-0535 (fax)

#### For Office Use Only:

Well #: 093H394  
 Aquifer: \_\_\_\_\_  
 E-Log #: \_\_\_\_\_

# RECEIVED

State Law requires that this report be prepared by the license holder responsible for the work and filed with the Department at the above address within 30 days of completion of drilling of the well or borehole. **MAR 08 2019**

<p><b>Well Owner Information</b>          (Landowner if borehole is not for a water well)</p> <p>Owner Name: <u>Mark Anderson</u>          Mailing Address: <u>543 Moore Loop</u>  <u>Byhalia</u> <u>MS</u> <u>38611</u>          City State Zip Code          Telephone No. (901) <u>301-5899</u></p>	<p><b>Well or Borehole Location</b></p> <p>Latitude: <u>34° 8' 17.73"</u> Longitude: <u>89° 6' 7.212"</u>  <u>34-49-38</u> <u>89-40-45.16</u>          Method of Lat/Long (check one): Conventional Survey _____          USGS quad _____, Hand-held GPS <input checked="" type="checkbox"/>, Survey-grade GPS _____  <u>S</u>W <input checked="" type="checkbox"/> <u>SE</u> <input checked="" type="checkbox"/> <u>13</u> T <u>35</u> R <u>5</u> W  <u>2</u> Miles <u>S</u> of <u>Byhalia</u>          (Distance) (Direction) (Nearest Town)</p>
--	--

**Well / Borehole Data**

Date drilling started: 1-7-19 Date drilling completed: 1-7-19 Hole depth: 105 Hole diameter: 8"  
 Location of the source of any surface water used for drilling: Well Water  
 Method of dosing and volume of Chlorine used in drilling and development: 1/2 lb Chlorine to 1000 gal Water  
 Logs run (circle all applicable):  No log run Electric Gamma Ray Density Sonic Neutron Other: \_\_\_\_\_  
 Name of organization running log(s): \_\_\_\_\_  
 Purpose of borehole (circle one):  Water Well Geotechnical/Geological Investigation Ground Source Heat Pump  
 Seismic Survey Other (describe) \_\_\_\_\_  
*If drilling is not related to water well construction, skip the remainder of this block*

Purpose of Well (circle all applicable):  Home Industrial Public Supply Irrigation Fish Culture  
 Other (describe): \_\_\_\_\_  
 If a flowing well, method of flow regulation: Valve \_\_\_\_\_ Other (describe) \_\_\_\_\_  
 Static Water Level: 40 feet [above or  below land surface Date measured: \_\_\_\_\_  
 (circle one)  
 Method of measurement (circle one):  Steel tape Electric tape Air line Other (describe): \_\_\_\_\_  
 Well depth: 105 Well grouted to a depth of: 10 feet Type of grout (circle one):  Neat Cement Bentonite Mix  
 Casing length: 90 feet Casing diameter: 4 inches Type of casing: PVC  
 Screen length: 10 feet Screen diameter: 4 inches Type of screen: PVC  
 Screen slot size: .013 inches Setting depth: From 95 feet to 105 feet  
 Type of completion (circle all applicable):  Gravel packed Underreamed Open hole Natural Development  
 Other (describe): \_\_\_\_\_  
 Top of lap pipe or reduction in casing: \_\_\_\_\_ feet  
*If telescoped or more than one screen, describe on next page*

# STATE WELL REPORT

Part 2

**Pump Installer's Completion Report**  
 Mississippi Department of Environmental Quality  
 Office of Land and Water Resources  
 P.O. Box 2309  
 Jackson, MS 39225-2309  
 (601)961-5210  
 (601) 360-0535 (fax)

For Office Use Only:

Well #: 093H3914

RECEIVED

Aquifer: \_\_\_\_\_

MAR 08 2019

County: Marshall  
 Permit #: 0-162  
 Driller: Larry Carpenter  
 Date completed: 1-7-19  
Copy information from block on Part 1

*This part of the report must be completed by a licensed water well contractor or a licensed pump installer. **BY OLWR** of the report must be attached and both parts filed with the Department at the above address within 30 days of well completion.*

Well Owner Information	Well Location
Owner Name: <u>Mark Anderson</u>	Latitude: <u>34° 8' 17.7" N</u> Longitude: <u>89° 6' 79.2" W</u>
Mailing Address: <u>543 Moore Loop</u>	Method of Lat/Long (check one): Conventional Survey _____, USGS quad _____, Hand-held GPS <input checked="" type="checkbox"/> , Survey-grade GPS _____
<u>Byhalia</u> <u>MS</u> <u>38611</u>	<u>SW</u> $\frac{1}{4}$ <u>SE</u> $\frac{1}{4}$ , Sec <u>13</u> T <u>3S</u> R <u>5W</u>
City State Zip Code	<u>2</u> Miles <u>S</u> of <u>Byhalia</u>
Telephone No. (901) <u>301-5899</u>	(Distance) (Direction) (Nearest Town)

**Pump Type (circle one)**

Submersible  Turbine  Air Lift  Centrifugal  Flowing Well  Jet  Piston  Rotary  Other (describe): \_\_\_\_\_

Date Pump Installed: 1-7-19 Rated Pump Capacity: 10 Gallons Per Minute

Is This Pump (circle one):  New  Repaired  Replacement

**Power Type (circle one)**

Electric  Diesel  Gasoline  Natural Gas  Tractor PTO  Windmill  Other (describe): \_\_\_\_\_

Horse Power Rating of Motor: 3/4 Setting Depth: 70 feet Number of Stages: 10

**Pump Test Data for Non Flowing Well**

Date Well Tested: 1-7-19 Duration of Pump Test (minimum 4 hours): 4 hours

Static Water Level (A): 40 Feet Below Land Surface Pumping Water Level (B): 60 Feet Below Land Surface

Drawdown [(B) - (A)]: 10 Feet Below Land Surface Test Pumping Rate: 10 Gallons Per Minute

Method of measurement (circle one): Steel tape  Electric tape  Air line  Other (describe): \_\_\_\_\_

**Pump Test Data for Flowing Well**

Measured shut in head: \_\_\_\_\_ feet.

Well yielded \_\_\_\_\_ GPM with a drawdown of \_\_\_\_\_ feet after \_\_\_\_\_ hours of pumping

**Meter Installation**

Meter Manufacturer: \_\_\_\_\_ Meter Serial Number: \_\_\_\_\_

Meter Model Number/Name: \_\_\_\_\_ Type of Meter: \_\_\_\_\_

Totalizer Register Unit and Multiplier Factor (AF x .001, gal x 1000, etc): \_\_\_\_\_

Installation Date: \_\_\_\_\_ Meter installed by: \_\_\_\_\_

Is This Meter (circle one):  New  Repaired  Replacement

*Important: By submitting the above information you are certifying that this meter was installed to manufacturer standards. For agricultural wells, a list of approved meters is on the MDEQ website.*

I HEREBY CERTIFY that the above statements are true to the best of my knowledge.


Larry Carpenter #0162 1-7-19 Larry Carpenter  
 Print Name of Pump Installer and License No. (if applicable) Date Signature of Pump Installer

County: Marshall  
 Permit #: 0162

**For Office Use Only:**  
 Well #: H 394

The sketch below only required for water wells

If well telescopes, show depths on sketch.

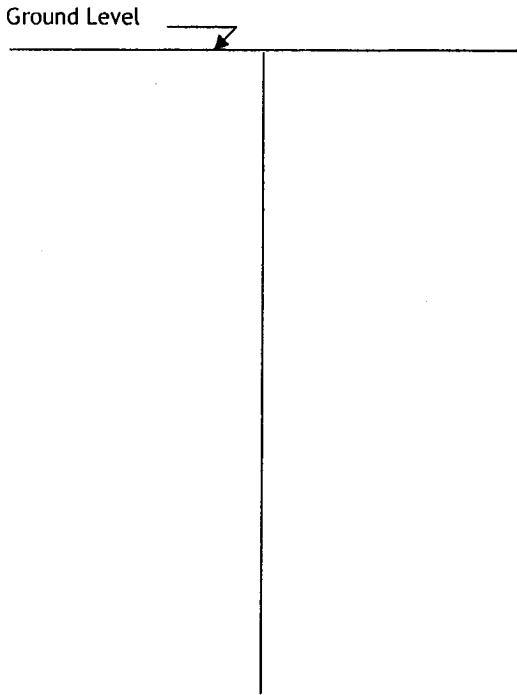


Description of formations encountered must be provided for all wells and boreholes, unless specifically exempted by regulations

Description of Formations Encountered	From (depth) Ground level	To (depth)
Surface Soil	0	20
Red Sand	20	38
White fine sand	38	60
Med White sand	60	90
Course White sand	90	105

If more than one screen, show location of each on sketch

- Sketch the property layout and include the following:
- 1) the well location
  - 2) any permanent structures on the property that may aid in locating the well
  - 3) any roads, power lines, or other items that may aid in locating the property and the well
  - 4) north arrow

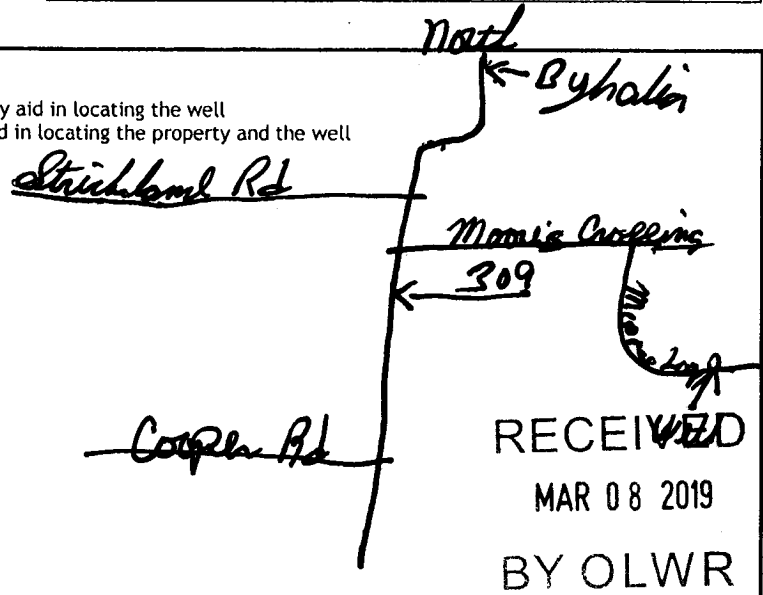

Landowner Name: Marb Anderson

I HEREBY CERTIFY that the well/borehole was drilled, constructed, and completed in accordance with all applicable requirements of the Mississippi Department of Environmental Quality and the Mississippi Department of Health regulations, if applicable, and state laws.

Larry Carpenter #0162 2-7-19 Larry Carpenter  
 Print Name of Responsible Licensee and License No. Date Signature of Licensee