

Marshall
H 200
6-21-75

MISSISSIPPI
BOARD OF WATER COMMISSIONERS
416 North State Street
Jackson, Mississippi 39201

WATER WELL DRILLERS LOG

6-21-1975 W.A. Mason ^{Water Well} Contractor Marshall
date well completed firm name county well located


LANDOWNER:	description of formations encountered	from	to
Charles Stiles	Clay Lint	00	15
RFD-Byhalia Miss. (mailing address)	Red Sand	15	25
WELL LOCATION:	pea gravel	25	30
sec. 10 T 3 N R 5 E 1 3/4 miles WEST of Warsaw (distance) (direction) (nearest town)	white sand	30	70
WELL PURPOSE: Home (home, irrigation, municipal, industrial)	white clay	70	100
WELL COMPLETION DATA:	white sand	100	130
(1) diameter (inches) 4			
(2) total depth (feet) 130			
(3) static water level (feet) 50 below top of ground.			
(4) casing Plastic 117 (material) (depth)			
4" if telescope see back. (size)			
(5) screen 13' 117 (length) (depth to top)			
4" Plastic (size) (material)			
(6) pump 3/4 10 (HP) (yield gpm)			
electric (type power)			
(7) electric log No (yes or no)			
(organization running log)			
(8) how well bottom plugged Cap on floor			
DRILLERS REMARKS:			

RECEIVED
FEB 17 1976

MISS. BD. OF WATER COMMISSIONERS

If well telescopes please sketch and show depths.

GROUND LEVEL

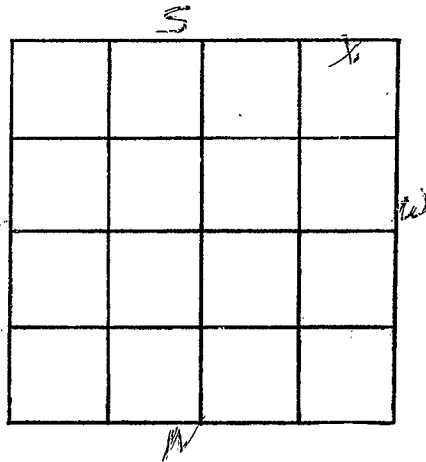

SECTION 10

Please indicate well location X.

ADDITIONAL INFORMATION

If more than one screen, show locations of each on sketch.