

Marshall
H 2001
7-8-75

MISSISSIPPI
BOARD OF WATER COMMISSIONERS
416 North State Street
Jackson, Mississippi 39201

WATER WELL DRILLERS LOG


7-8-1975 ^{15E} W.R. Mason Water Well Contractors Marshall
date well completed firm name county well located

LANDOWNER:	description of formations encountered	from	to
Ed Ateavago			
At. Byhalia Moan (mailing address)	gravel	20	50
WELL LOCATION:			
sec. 3 T. 3 N. R. 5 E. 1 1/2 miles SW of Byhalia (distance) (direction) (nearest town)	Red sand	50	80
	White sand	80	100
WELL PURPOSE: Home (home, irrigation, municipal, industrial)			
WELL COMPLETION DATA:			
(1) diameter (inches) 4"			
(2) total depth (feet) 100'			
(3) static water level (feet) 55' below top of ground.			
(4) casing Plaster, 90' (material) (depth) 4" if telescope see back. (size)			
(5) screen 10' - 90' (length) (depth to top) 4" Plaster (size) (material)			
(6) pump 3/4 HP 10 (HP) (yield gpm) Electric (type power)			
(7) electric log No (yes or no) (organization running log)			
(8) how well bottom plugged <i>cap</i>			
DRILLERS REMARKS:			

RECORDED
INDEXED
FEB 17 1976
MISS. Bd. OF WATER COMMISSIONERS

If well telescopes please sketch and show depths.

GROUND LEVEL

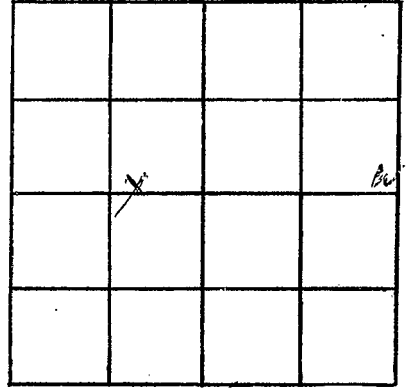

SECTION 3

Please indicate well location X.

ADDITIONAL INFORMATION

If more than one screen,
show locations of each on sketch.