

Marshall
H 2002
8-23-75

MISSISSIPPI
BOARD OF WATER COMMISSIONERS
416 North State Street
Jackson, Mississippi 39201

WATER WELL DRILLERS LOG

8-23-1975 ^{W.H. Mason &} Water Well Contractor Marshall
date well completed firm name county well located

LANDOWNER:
R. H. Cady
Rt. 2 - Byhalia Miss.
(mailing address)

WELL LOCATION:
sec. 26 T. 3 N. R. 5 E.
1 miles NW of Watson
(distance) (direction) (nearest town)

WELL PURPOSE: Home
(home, irrigation, municipal, industrial)

WELL COMPLETION DATA:

(1) diameter (inches) 4"

(2) total depth (feet) 109'

(3) static water level (feet) 63' below ~~above~~ top of ground.

(4) casing Plastic, 97'
(material) (depth)

4" If telescope see back.
(size)

(5) screen 12', 97'
(length) (depth to top)

4", Plastic
(size) (material)

(6) pump 3/4, 12
(HP) (yield gpm)

Electric
(type power)

(7) electric log NO
(yes or no)

(organization running log)

(8) how well bottom plugged CRP


description of formations encountered	from	to
<u>Clay loam</u>	<u>40</u>	<u>15</u>
<u>Red clay</u>	<u>15</u>	<u>30</u>
<u>White clay</u>	<u>30</u>	<u>50</u>
<u>White sand</u>	<u>50</u>	<u>109</u>

DRILLERS REMARKS:

MISSISSIPPI BOARD OF WATER COMMISSIONERS
FEB 17 1976
MISS. Bd. OF WATER COMMISSIONERS

If well telescopes please sketch and show depths.

GROUND LEVEL

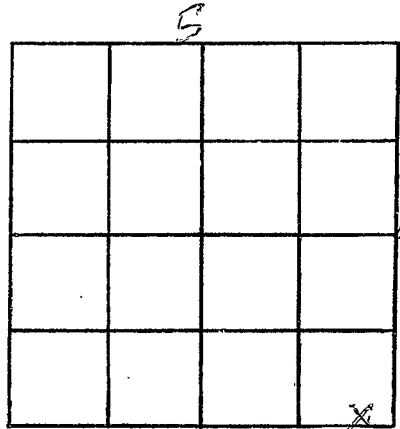

SECTION 26

Please indicate well location X.

ADDITIONAL INFORMATION

If more than one screen,
show locations of each on sketch.