

Marshall  
H 2003  
9-29-75

MISSISSIPPI  
BOARD OF WATER COMMISSIONERS  
416 North State Street  
Jackson, Mississippi 39201

15E

WATER WELL DRILLERS LOG

W.A. Mason  
Water Well Contractor

Marshall

9-29-75  
date well completed

1975  
firm name

county well located

LANDOWNER: Wesley Wood  
RT. 2  
Byhalia Miss.  
(mailing address)

description of formations encountered

from to

Clay dirt	70	8
Red clay	8	30
Red sand	30	40
gravel	40	60
yellow sand	60	93

WELL LOCATION:  
sec. 11 T 3 N R 5 E  
1/2 miles North of W. Woodson  
(distance) (direction) (nearest town)

WELL PURPOSE: Home  
(home, irrigation, municipal, industrial)

WELL COMPLETION DATA:  
(1) diameter (inches) 4"  
(2) total depth (feet) 93'  
(3) static water level (feet) 60 below  
top of ground. above  
(4) casing Plastic, 83'  
(material) (depth)  
4"  
(size) if telescope see back.  
(5) screen 10', 83'  
(length) (depth to top)  
4", Plastic  
(size) (material)  
(6) pump 1/3, 5  
(HP) (yield gpm)  
electric  
(type power)  
(7) electric log No  
(yes or no)  
(organization running log)

(8) how well bottom plugged  
Cap on screen


DRILLERS REMARKS:

RECEIVED  
FEB 17 1976

MISS. BD. OF WATER COMMISSIONERS

If well telescopes please sketch and show depths.

GROUND LEVEL

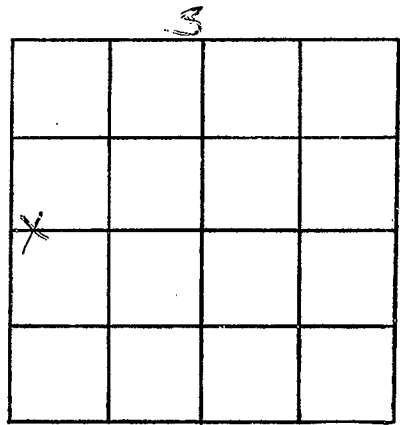

SECTION 11

Please indicate well location X.

ADDITIONAL INFORMATION

If more than one screen,  
show locations of each on sketch.