

Marshall
H 2004
12-23-75

MISSISSIPPI
BOARD OF WATER COMMISSIONERS
416 North State Street
Jackson, Mississippi 39201

156

WATER WELL DRILLERS LOG

12-23-75 W.A. Mason Water Well Contractor Marshall
date well completed firm name county well located

LANDOWNER:
Bary J. Looney
Rt. Bethalia Miss.
(mailing address)

description of formations encountered	from	to
clay silt	0	15
red clay	15	25
yellow sand	25	70
lignite sand	70	135

WELL LOCATION:
sec 3 T 3 N R 5 E
1 1/2 miles SW of Bethalia
(distance) (direction) (nearest town)

WELL PURPOSE: Home
(home, irrigation, municipal, industrial)

WELL COMPLETION DATA:

(1) diameter (inches) 4"

(2) total depth (feet) 135'

(3) static water level (feet) 80 below top of ground.

(4) casing Plaster, 125' (material) (depth)
4" (size) if telescope see back.


(5) screen 10' (length), 125' (depth to top)
4" (size), Plaster (material)

(6) pump 3/4 (HP), 10 (yield gpm)
electric (type power)

(7) electric log NO (yes or no)

(organization running log)

(8) how well bottom plugged cap

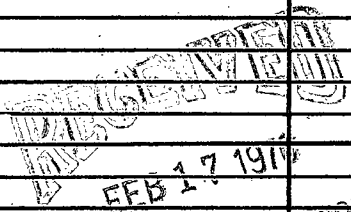


DRILLERS REMARKS:

MISS. Bd. OF WATER COMMISSIONERS

If well telescopes please sketch and show depths.

GROUND LEVEL

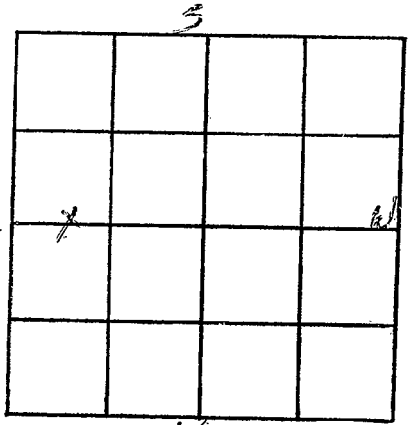

SECTION 3

Please indicate well location X.

ADDITIONAL INFORMATION

If more than one screen, show locations of each on sketch.