

MARSHALL
 H 2005
 4-10-76

MISSISSIPPI
 BOARD OF WATER COMMISSIONERS
 416 North State Street
 Jackson, Mississippi 39201

WATER WELL DRILLERS LOG

4-10 1976 *Atkinson & Hart Marshall*
 date well completed firm name county well located

LANDOWNER:
Jeralean W Brown
Byhalia Miss
 (mailing address)

description of formations encountered	from	to
<i>Brown Clay</i>	0	10
<i>Sand</i>	10	60
<i>White Clay</i>	60	70
<i>White Sand</i>	70	130

WELL LOCATION:
 sec. *B T 3 N* R. *6 E*
2 miles *SE* of *Byhalia*
 (distance) (direction) (nearest town)

WELL PURPOSE:
 (home, irrigation, municipal, industrial)

- WELL COMPLETION DATA:
- (1) diameter (inches) 4
 - (2) total depth (feet) 130
 - (3) static water level (feet) 60 below top of ground.
 - (4) casing PVC (material) (depth) _____
 _____ (size) if telescope see back.
 - (5) screen _____ (length) _____ (depth to top)
 _____ (size) _____ (material)
 - (6) pump 3/4 (HP) 15 (yield gpm)
Free (type power)
 - (7) electric log (yes or no) _____
 _____ (organization running log)
 - (8) how well bottom plugged 0


RECEIVED
 DECEMBER 1976
 JUN - 4 1976

DRILLERS REMARKS:

MISS. BOARD OF WATER COMMISSIONERS

If well telescopes please sketch and show depths.

GROUND LEVEL

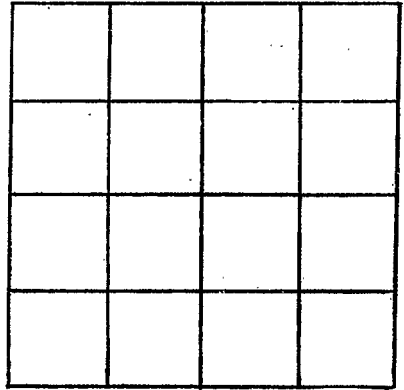

SECTION _____

Please indicate well location X.

ADDITIONAL INFORMATION

If more than one screen,
show locations of each on sketch.