

Marshall
H 2007

MISSISSIPPI
BOARD OF WATER COMMISSIONERS
416 North State Street
Jackson, Mississippi 39201

WATER WELL DRILLERS LOG

3/1/97
date well completed

Atkinson Fast
firm name

Marshall
county well located

LANDOWNER: Raymond
Webster

description of formations encountered	from	to
CLAY	0	15
SAND	15	40
CLAY	40	50
White SAND	50	110

Bahalia Miss
(mailing address)

WELL LOCATION:
sec. 3 T 3 N R 15 E if NW
2 1/2 miles NW of Webster
(distance) (direction) (nearest town)

WELL PURPOSE: home
(home, irrigation, municipal, industrial)

- WELL COMPLETION DATA:
- (1) diameter (inches) 4"
 - (2) total depth (feet) 110
 - (3) static water level (feet) 60 below top of ground.
 - (4) casing PVC 110
(material) (depth)
If telescope see back.
(size)
 - (5) screen 10' 100
(length) (depth to top)
4" PVC
(size) (material)
 - (6) pump 1/2 10
(HP) (yield gpm)
Elec
(type power)
 - (7) electric log NO
(yes or no)
NO
(organization running log)
 - (8) how well bottom plugged CAP.

RECEIVED


MAR 28 1977

DRILLERS REMARKS:

MISS. B WATER COMM

If well telescopes please sketch and show depths.

GROUND LEVEL

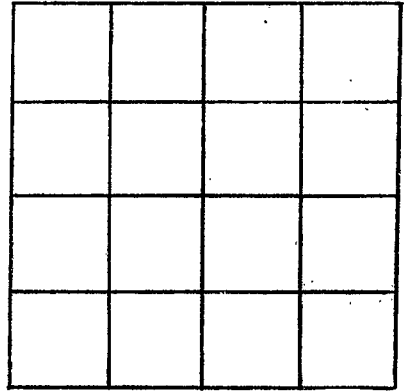

SECTION _____

Please indicate well location X.

ADDITIONAL INFORMATION

If more than one screen,
show locations of each on sketch.