

Marshall
H 2008
5-30/76

MISSISSIPPI
BOARD OF WATER COMMISSIONERS
416 North State Street
Jackson, Mississippi 39201

WATER WELL DRILLERS LOG

5-30-76 date well completed
Bob Smith Well Drilling firm name
Marshall county well located


LANDOWNER:	description of formations encountered	from	to
Richard Wiseman Rt 2 - Box 104 C	Red clay Sand	0	17
By Haley, Ms. (mailing address)		17	114
WELL LOCATION:			
sec 26 T 3 N R 5 E S 8 miles of By Haley (distance) (direction) (nearest town)			
WELL PURPOSE: (home, irrigation, municipal, industrial)			
WELL COMPLETION DATA:			
(1) diameter (inches)	4"		
(2) total depth (feet)	114		
(3) static water level (feet)	71 below top of ground.		
(4) casing	P.V.C.	104	(depth)
(size)	if telescope see back.		
(5) screen	10'	104	(length) (depth to top)
(size)	(material)		
(6) pump	1/2	10	(HP) (yield gpm)
(type power)	Electric		
(7) electric log	no (yes or no)		
(organization running log)			
(8) how well bottom plugged	Solid		
DRILLERS REMARKS:			

RECEIVED
NOV - 7 1977

MISS. BD. OF WATER COMM.

If well telescopes please sketch and show depths.

GROUND LEVEL

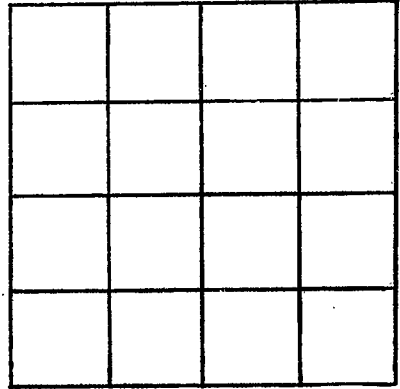

SECTION _____

Please indicate well location X.

ADDITIONAL INFORMATION

If more than one screen,
show locations of each on sketch.