

MARSHALL  
H 2010  
9-1-76

MISSISSIPPI  
BOARD OF WATER COMMISSIONERS  
416 North State Street  
Jackson, Mississippi 39201

WATER WELL DRILLERS LOG

15E  
9-1-1-1976 *W.C. Mason* firm name  
*W.C. Mason Well Co.* county well located  
*Marshall*

LANDOWNER:

*Herbert Dickinson*  
*RFD Bethalia Miss.*  
(mailing address)

description of formations encountered

from	to
<i>20</i>	<i>10</i>
<i>10</i>	<i>35</i>
<i>35</i>	<i>50</i>
<i>50</i>	<i>140</i>

*Clay silt*  
*Gravel*  
*Red sand*  
*Crushed sand*

WELL LOCATION:

sec. *27* T. *3* N R. *5* E  
*2 1/4* miles *NW* of *WATER*  
(distance) (direction) (nearest town)

WELL PURPOSE: *HOME*  
(home, irrigation, municipal, industrial)

WELL COMPLETION DATA:

- (1) diameter (inches) *4"*
- (2) total depth (feet) *140'*
- (3) static water level (feet) *6'* below top of ground
- (4) casing *Plastic* (material) *130'* (depth)  
*2"* (size) If telescope see back.
- (5) screen *10'* (length) *130'* (depth to top)  
*4"* (size) *Plastic* (material)
- (6) pump *3/4* (HP) *10* (yield gpm)  
*Electric* (type power)
- (7) electric log *No* (yes or no)

(organization running log)

(8) how well bottom plugged *Cap*


DRILLERS REMARKS:

**RECEIVED**  
JUL 7 1977

MISS. BOARD OF WATER COMMISSIONERS

If well telescopes please sketch and show depths.

GROUND LEVEL

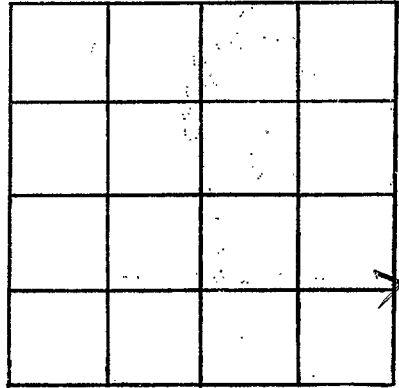

SECTION

27

Please indicate well location X.

ADDITIONAL INFORMATION

If more than one screen, show locations of each on sketch.