

MARSHALL  
H 2011  
10-24-76

MISSISSIPPI  
BOARD OF WATER COMMISSIONERS  
416 North State Street  
Jackson, Mississippi 39201

WATER WELL DRILLERS LOG

10-24-76 date well completed  
W.A. Marshall firm name  
Marshall county well located

LANDOWNER:

J.B. O'Jain  
RFD Byhalia Miss (mailing address)

description of formations encountered

from to

clay loam 20 6  
white sand 6 94

WELL LOCATION:

sec. 11 T. 3 N R. 5 E  
3/4 miles west of Warsaw  
(distance) (direction) (nearest town)

WELL PURPOSE: Home  
(home, irrigation, municipal, industrial)

WELL COMPLETION DATA:

- (1) diameter (inches) 4"
- (2) total depth (feet) 98'
- (3) static water level (feet) 15' below top of ground
- (4) casing Plastic, 88' (material) (depth)  
4" if telescope see back. (size)
- (5) screen 10', 88' (length) (depth to top)  
4", Plastic (size) (material)
- (6) pump 3/4, 10 (HP) (yield gpm)  
electric (type power)
- (7) electric log No (yes or no)

(organization running log)

(8) how well bottom plugged cap

DRILLERS REMARKS:


RECEIVED

JUL 7 - 1977

MISS. BLD. OF WATER COMMISSIONERS

If well telescopes please sketch and show depths.

GROUND LEVEL

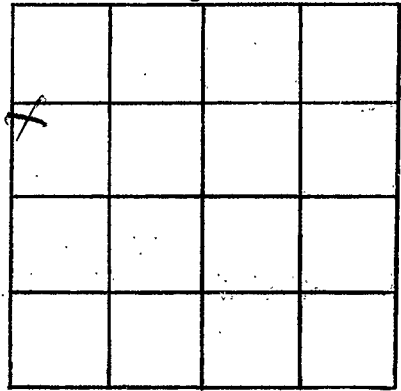

SECTION 11

Please indicate well location X.

ADDITIONAL INFORMATION

If more than one screen, show locations of each on sketch.