

MARSHALL
H 2013
4-8-77

MISSISSIPPI
 BOARD OF WATER COMMISSIONERS
 416 North State Street
 Jackson, Mississippi 39201

WATER WELL DRILLERS LOG

4-8-77 date well completed
W.A. Masons firm name
Marshall county well located

LANDOWNER:

Walter D. Hurless
Rt. 2, Byhalia, Miss.
 (mailing address)

description of formations encountered

from to

<u>clay</u>	<u>15</u>	<u>15</u>
<u>red sand</u>	<u>15</u>	<u>22</u>
<u>white clay</u>	<u>22</u>	<u>60</u>
<u>white sand</u>	<u>60</u>	<u>110'</u>

WELL LOCATION:

sec 26 T 3 N R 5 E
1/4 miles North of Watson
 (distance) (direction) (nearest town)

WELL PURPOSE: drinking
 (home, irrigation, municipal, industrial)

WELL COMPLETION DATA:

- (1) diameter (inches) 4"
- (2) total depth (feet) 110'
- (3) static water level (feet) 5' below top of ground.
- (4) casing Plastic 100'
 (material) (depth)
4"
 (size) If telescope see back.
- (5) screen _____ (length) _____ (depth to top)
 (size) _____ (material)
- (6) pump 3/4" 10
 (HP) (yield gpm)
electric
 (type power)
- (7) electric log NO
 (yes or no)
 (organization running log)
- (8) how well bottom plugged Cap


RECEIVED
 JUL 7 - 1977

DRILLERS REMARKS:

MISS. BD. OF WATER COMMISSIONERS

If well telescopes please sketch and show depths.

GROUND LEVEL

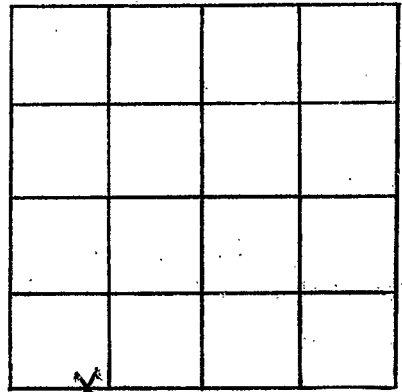

SECTION 26

Please indicate well location X.

ADDITIONAL INFORMATION

If more than one screen, show locations of each on sketch.