

Marshall
H 2015
June 15, 1977

MISSISSIPPI
BOARD OF WATER COMMISSIONERS
416 North State Street
Jackson, Mississippi 39201

WATER WELL DRILLERS LOG

June 15 1977 ^{15E} Leake Well Co Marshall
date well completed firm name county well located

LANDOWNER: H. Williams
Brykela Road
Brykela, Miss
(mailing address)

description of fomations encountered	from	to
Surface Clay	1	12
Clay & Sand	12	70
Coarse SAND	70	130

WELL LOCATION:
sec. 1 T. 3 N R. 5 E
1/2 miles S of Brykela
(distance) (direction) (nearest town)

WELL PURPOSE: Domestic
(home, irrigation, municipal, industrial)

- WELL COMPLETION DATA:
- (1) diameter (inches) 4
 - (2) total depth (feet) 130
 - (3) static water level (feet) 62 below top of ground.
 - (4) casing PVC 130
(material) (depth)
(size) if telescope see back.
 - (5) screen 10' 120
(length) (depth to top)
H PVC
(size) (material)
 - (6) pump 1/2 15
(HP) (yield gpm)
Elce
(type power)
 - (7) electric log NO
(yes or no)
 - (8) how well bottom plugged PVC CAP


DRILLERS REMARKS:

RECEIVED
JUN 27 1977

MISS. BD. OF WATER COMMISSIONERS

If well telescopes please sketch and show depths.

GROUND LEVEL

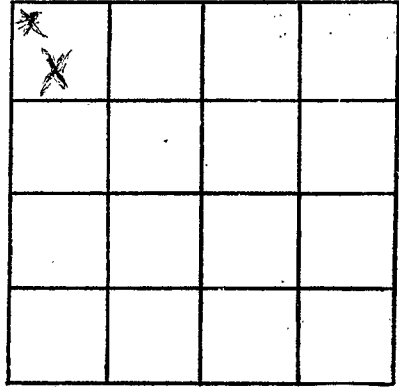

SECTION 1

Please indicate well location X.

ADDITIONAL INFORMATION

If more than one screen,
show locations of each on sketch.