

Marshall
H 206
6/22/77

MISSISSIPPI
BOARD OF WATER COMMISSIONERS
416 North State Street
Jackson, Mississippi 39201
WATER WELL DRILLERS LOG

6-22 19 77 Wilson Well Co. Inc. Marshall
date well completed firm name county well located

LANDOWNER:
Wank Hunt
Byhalia, Miss
(mailing address)

description of formations encountered	from	to
Red clay	0	2
Blue & Sand clay	2	15
Red Sand & Gravel	15	30
white Sand	30	145

WELL LOCATION:
sec. 14 T. 3 N R. 5 W
miles of
(distance) (direction) (nearest town)

WELL PURPOSE:
(home, irrigation, municipal, industrial)

- WELL COMPLETION DATA:
- (1) diameter (inches) 4
 - (2) total depth (feet) 145
 - (3) static water level (feet) 20 below top of ground.
 - (4) casing (material) 125 (depth)
(size) If telescope see back.
 - (5) screen 20 (length) (depth to top)
(size) gravel packed (material)
 - (6) pump 2 (HP) (yield gpm)
electric (type power)
 - (7) electric log (yes or no)
(organization running log)
 - (8) how well bottom plugged


RECEIVED
DEC 21 1977

MISS. BD. OF WATER COMM
MISS. BD. OF WATER COMM

DRILLERS REMARKS:

If well telescopes please sketch and show depths.

GROUND LEVEL

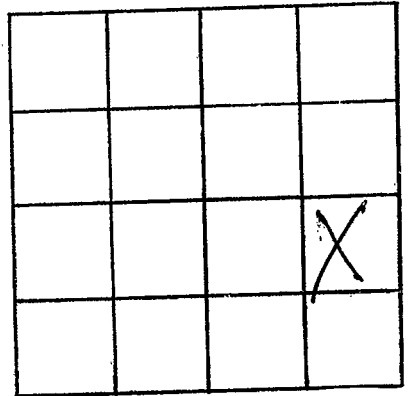

SECTION 14

Please indicate well location X.

ADDITIONAL INFORMATION

Lined area for additional information.

If more than one screen, show locations of each on sketch.