

Marshall
H 2017
8/2-77

MISSISSIPPI
BOARD OF WATER COMMISSIONERS
416 North State Street
Jackson, Mississippi 39201

WATER WELL DRILLERS LOG

8-2-77 date well completed
W.A. Mason Water Well Co. firm name
Marshall county well located

LANDOWNER:
Audrey L. Swain
RFD - Bayhelia Miss.
(mailing address)

description of formations encountered	from	to
clay dirt	70	20
Red clay	20	60
white sand	60	130

WELL LOCATION:
sec. 25 T 3 N R 5 E
3/4 miles NE of Water
(distance) (direction) (nearest town)

WELL PURPOSE: Home
(home, irrigation, municipal, industrial)

- WELL COMPLETION DATA:
- (1) diameter (inches) 4"
 - (2) total depth (feet) 130'
 - (3) static water level (feet) 73' below top of ground
 - (4) casing (material) (depth)
Pre-Plastic 120'
 - 4" (size) If telescope see back.
 - (5) screen 10' 120'
(length) (depth to top)
4" (size) Plastic (material)
 - (6) pump 3/4 10
(HP) (yield gpm)
electric (type power)
 - (7) electric log No
(yes or no)

(organization running log)

(8) how well bottom plugged Cap


DRILLERS REMARKS:

RECEIVED
DEC 12 1977

MISS. BD. OF WATER COMMISSIONERS

If well telescopes please sketch and show depths.

GROUND LEVEL

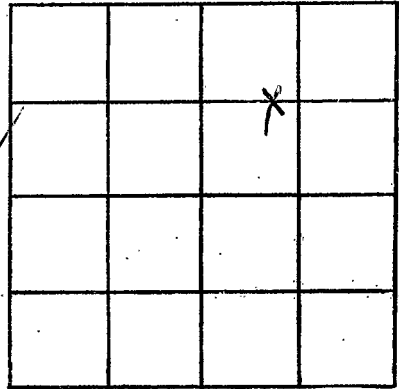

SECTION 25

Please indicate well location X.

ADDITIONAL INFORMATION

If more than one screen, show locations of each on sketch.