

Marshall
H 2018
8/3/77

MISSISSIPPI
BOARD OF WATER COMMISSIONERS
416 North State Street
Jackson, Mississippi 39201

WATER WELL DRILLERS LOG

8-3-1977 date well completed
W.A. Mason Waterwell Center firm name
Marshall county well located

LANDOWNER:
James Wheeler
At: Byhaba Miss.
(mailing address)

description of formations encountered	from	to
Clay silt		10
Red clay	10	63
White sand	63	138


WELL LOCATION:
sec. 25 T. 3 N R. 5 E
3/4 miles N of Watson
(distance) (direction) (nearest town)

WELL PURPOSE: Home
(home, irrigation, municipal, industrial)

- WELL COMPLETION DATA:
- (1) diameter (inches) 4"
 - (2) total depth (feet) 138'
 - (3) static water level (feet) 75' below top of ground.
 - (4) casing (material) (depth)
PVC Plastic 128'
4" If telescope see back.
(size)
 - (5) screen 10' 128'
(length) (depth to top)
4" Plastic
(size) (material)
 - (6) pump 3/4 10
(HP) (yield gpm)
electra
(type power)
 - (7) electric log NO
(yes or no)

(organization running log)
(8) how well bottom plugged cap


DRILLERS REMARKS:

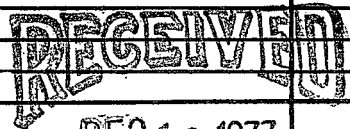

DEC 12 1977

If well telescopes please sketch and show depths.

GROUND LEVEL

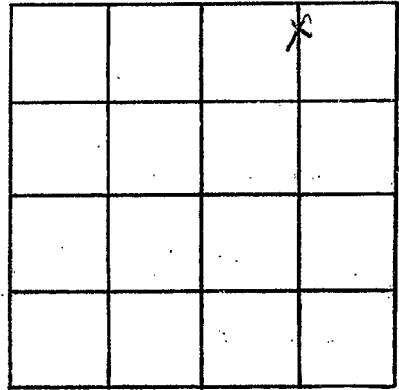

SECTION S 25

Please indicate well location X.

ADDITIONAL INFORMATION

If more than one screen, show locations of each on sketch.