

MARSHALL
H 2019
8/8/77

MISSISSIPPI
 BOARD OF WATER COMMISSIONERS
 416 North State Street
 Jackson, Mississippi 39201

WATER WELL DRILLERS LOG

August 8 1977 Earl Jones Well Co Marshall
 date well completed firm name county well located

LANDOWNER:
Joe Sanders
Byhalia Miss. Rt.
 (mailing address)

WELL LOCATION:
 sec 3 T. 23 N R. 5 E
1/2 miles SW of Byhalia
 (distance) (direction) (nearest town)

WELL PURPOSE: Home
 (home, irrigation, municipal, industrial)

description of formations encountered	depth	
	from	to
<u>topsoil & clay</u>	<u>0</u>	<u>15</u>
<u>sand</u>	<u>15</u>	<u>20</u>
<u>gravel</u>	<u>20</u>	<u>30</u>
<u>clay</u>	<u>30</u>	<u>40</u>
<u>gravel</u>	<u>40</u>	<u>45</u>
<u>clay</u>	<u>45</u>	<u>60</u>
<u>sand</u>	<u>60</u>	<u>80</u>
<u>clay</u>	<u>80</u>	<u>84</u>
<u>sand</u>	<u>84</u>	<u>150</u>

WELL COMPLETION DATA:

(1) diameter (inches) 4

(2) total depth (feet) 150

(3) static water level (feet) 118 below above top of ground.

(4) casing plastic 140
 (material) (depth)
4
 (size) if telescope see back.

(5) screen 10 140
 (length) (depth to top)
4"-D13 plastic
 (size) (material)

(6) pump 1/2 15
 (HP) (yield gpm)
electric
 (type power)

(7) electric log no
 (yes or no)
no
 (organization running log)

(8) how well bottom plugged
plastic cap


DRILLERS REMARKS:

RECEIVED
 SEP 12 1977

MISSISSIPPI WATER COMMISSIONERS

If well telescopes please sketch and show depths.

GROUND LEVEL

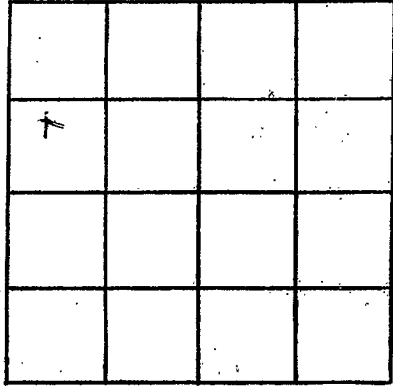

SECTION 3

Please indicate well location X.

ADDITIONAL INFORMATION

A series of horizontal lines providing space for additional information.

If more than one screen, show locations of each on sketch.