

Marshall
H 2020
10/22/77

MISSISSIPPI
BOARD OF WATER COMMISSIONERS
416 North State Street
Jackson, Mississippi 39201

WATER WELL DRILLERS LOG

10-22-77 date well completed
W.A. Mason Water Well Drilling firm name
Marshall county well located

LANDOWNER:
Robert Richmond
RFD-Byhalia Miss
(mailing address)

description of formations encountered	from	to
Clay	0	10
Red Sand	10	40
White Sand	40	112

WELL LOCATION:
sec 12 T. 3 N R. 5 E
1 1/2 miles NE of Wadsworth
(distance) (direction) (nearest town)

WELL PURPOSE: Home
(home, irrigation, municipal, industrial)

WELL COMPLETION DATA:

(1) diameter (inches) 4" ~~4 1/2"~~

(2) total depth (feet) ~~112~~ 112'

(3) static water level (feet) 50' below top of ground above

(4) casing Plastic 102'
(material) (depth)
4" If telescope see back.
(size)

(5) screen 10' 102'
(length) (depth to top)
4" Plastic
(size) (material)

(6) pump 3/4 10
(HP) (yield gpm)
electric
(type power)

(7) electric log No
(yes or no)

(organization running log)

(8) how well bottom plugged Cap


RECEIVED

DEC 12 1977

DRILLERS REMARKS:

If well telescopes please sketch and show depths.

GROUND LEVEL

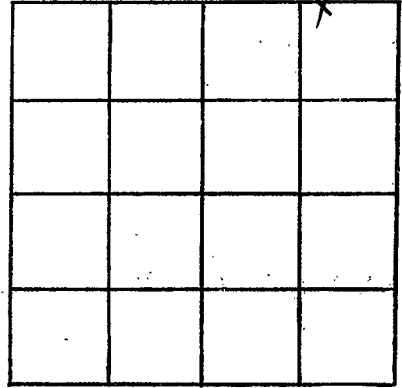

SECTION 12

Please indicate well location X.

ADDITIONAL INFORMATION

If more than one screen, show locations of each on sketch.