

Marshall
 H 2021
 11/18/77

MISSISSIPPI
 BOARD OF WATER COMMISSIONERS
 416 North State Street
 Jackson, Mississippi 39201

WATER WELL DRILLERS LOG

11-18-1977 date well completed
 W.A. Mason Water Well Co. firm name
 Marshall county well located

LANDOWNER:	description of formations encountered	from	to
J.P. Shelton Jr. R.F.D. Pyhalia Miss (mailing address)	Clay gravel white sand	0 12 52	12 52 128
WELL LOCATION:			
sec. <u>26</u> T. <u>3</u> N. <u>5</u> R. <u>5</u> E. W. <u>5</u> 1/4 miles <u>12</u> of <u>Watauga</u> (distance) (direction) (nearest town)			
WELL PURPOSE: <u>Home</u> (home, irrigation, municipal, industrial)			
WELL COMPLETION DATA:			
(1) diameter (inches) <u>4"</u>			
(2) total depth (feet) <u>128'</u>			
(3) static water level (feet) <u>70</u> below above top of ground.			
(4) casing <u>Plastr.</u> <u>118'</u> (material) (depth) <u>4"</u> if telescope see back. (size)			
(5) screen <u>10'</u> <u>118'</u> (length) (depth to top) <u>4"</u> <u>Plastr.</u> (size) (material)			
(6) pump <u>3/4</u> <u>10</u> (HP) (yield gpm)			
<u>Electric</u> (type power)			
(7) electric log <u>NO</u> (yes or no)			
(organization running log)			
(8) how well bottom plugged <u>cap</u>			
DRILLERS REMARKS:			


RECEIVED

DEC 12 1977

MISS. BD. OF WATER COM.

If well telescopes please sketch and show depths.

GROUND LEVEL

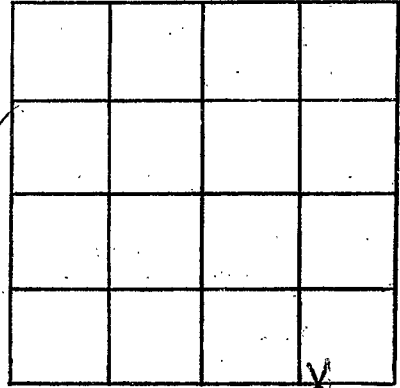

SECTION

2b

Please indicate well location X.

ADDITIONAL INFORMATION

If more than one screen, show locations of each on sketch.