

MARSHALL
 H 2022
 3-2B-79

MISSISSIPPI
 BOARD OF WATER COMMISSIONERS
 416 North State Street
 Jackson, Mississippi 39201

WATER WELL DRILLERS LOG

Marshall

3/16

79 Rich Well Co.

Asota

date well completed

firm name

county well located

LANDOWNER:

James Payne
 Bayholia Miss.
 (mailing address)

description of formations encountered

from

to

Red clay	0	10
Red clay + sand	10	90
White sand + clay	90	100
White sand + clay	100	120
White sand	120	150

WELL LOCATION:

sec. 3 T. 3 N. R. 5 E.
 1 miles South of Bayholia
 (distance) (direction) (nearest town)

WELL PURPOSE:

Home
 (home, irrigation, municipal, industrial)

WELL COMPLETION DATA:

- (1) diameter (inches) 4 in
- (2) total depth (feet) 150
- (3) static water level (feet) 110 below above top of ground:
- (4) casing Plastic, 150,
 (material) (depth)
 (size) if telescope see back.
- (5) screen 7ft., 143
 (length) (depth to top)
4in, Gravel
 (size) (material).
- (6) pump 1/2, 10
 (HP) (yield: gpm)
220
 (type power)
- (7) electric log No
 (yes or no)
- (organization running log)
- (8) how well bottom plugged Cap

Miss. Board of Water Comm.


MAR 27 1979

DRILLERS REMARKS:

RECEIVED

If well telescopes please
sketch and show depths.

GROUND LEVEL

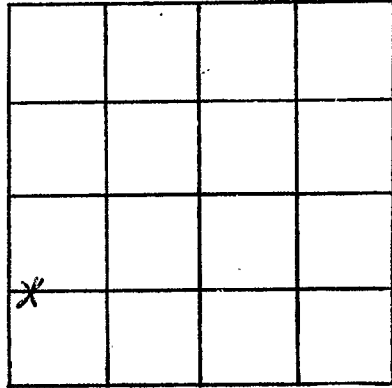

SECTION 3

Please indicate well location X.

ADDITIONAL INFORMATION

If more than one screen,
show locations of each on sketch.