

Marshall
H 206
5-10-79

MISSISSIPPI
BOARD OF WATER COMMISSIONERS
416 North State Street
Jackson, Mississippi 39201

WATER WELL DRILLERS LOG

May 10 19 79 Earl Jones Well Co Marshall
date well completed firm name county well located

LANDOWNER:	description of formations encountered	from	to
Viola McNeal			
Byholts Miss. (mailing address)	Sand	18	26
	clay	26	35
	Sand	35	70
	clay	70	76
	sand	76	132
WELL LOCATION: sec 3 T 1 N R 5 E 1 miles W of Byholts (distance) (direction) (nearest town)			
WELL PURPOSE: Home (home, irrigation, municipal, industrial)			
WELL COMPLETION DATA:			
(1) diameter (inches) 2"			
(2) total depth (feet) 132			
(3) static water level (feet) 85 below top of ground.			
(4) casing plastic, 122' (material) (depth) 2" if telescope see back. (size)			
(5) screen 10' length, 122' depth to top 1/3-4" plastic (size) (material)			
(6) pump 1 HP, 5 yield gpm Electric (type power)			
(7) electric log no (yes or no)			
(organization running log)			
(8) how well bottom plugged plastic cap			
DRILLERS REMARKS:			


Miss. Board of Water Comm

MAY 31 1979

RECEIVED

If well telescopes please sketch and show depths.

GROUND LEVEL

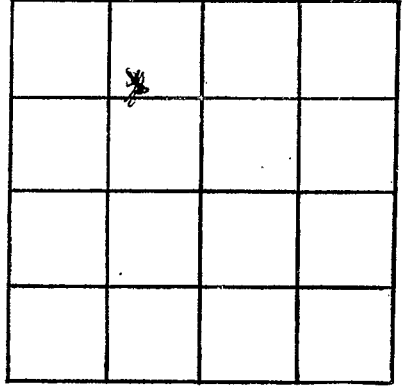

SECTION 3

Please indicate well location X.

ADDITIONAL INFORMATION

If more than one screen, show locations of each on sketch.