

MARSHALL

H 227

5-29-79

MISSISSIPPI BOARD OF WATER COMMISSIONERS
416 North State Street
Jackson, Mississippi 39201

WATER WELL DRILLERS LOG

June 28
date well completed

1979 Earl Jones Well Co.
firm name

Marshall
county well located

LANDOWNER:

Jack T. Lester

Byholio Miss. RT.
(mailing address)

WELL LOCATION:

sec. 11 T. 3 N R. 5 E
S W
2 miles S of Byholio
(distance) (direction) (nearest town)

WELL PURPOSE: Home
(home, irrigation, municipal, industrial)

WELL COMPLETION DATA:

- (1) diameter (inches) 4"
 - (2) total depth (feet) 120
 - (3) static water level (feet) 62 below above top of ground.
 - (4) casing plastic 110
(material) (depth)
4" (size) If telescope see back.
 - (5) screen 10' 110
(length) (depth to top)
 - 4" 0/3 plastic
(size) (material)
 - (6) pump 1/2 16
(HP) (yield gpm)
Electric
(type power)
 - (7) electric log no
(yes or no)
- (organization running log)

(8) how well bottom plugged
plastic cap

DRILLERS REMARKS:

description of formations encountered

from to

Topsail + clay	0	14
sand	14	30
clay	30	38
sand	38	56
clay	56	65
sand	65	78
clay	78	92
sand	92	120


Miss. Board of Water Comm.

JUL 30 1979

RECEIVED

If well telescopes please sketch and show depths.

GROUND LEVEL

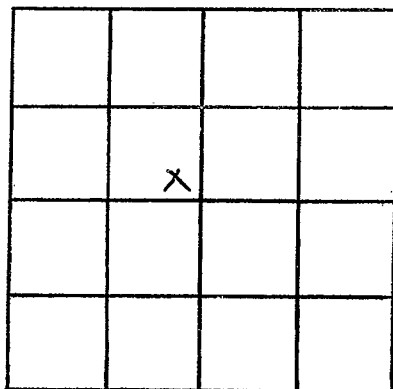

SECTION 11

Please indicate well location X.

ADDITIONAL INFORMATION

If more than one screen,
show locations of each on sketch.