

MARSHALL  
H 228  
6-9-79

MISSISSIPPI  
BOARD OF WATER COMMISSIONERS  
416 North State Street  
Jackson, Mississippi 39201

WATER WELL DRILLERS LOG

6/19/79 19 79 Hills Well Co. Marshall  
date well completed firm name county well located

LANDOWNER:  
Perry Anthony  
Bayholic Miss  
(mailing address)

description of formations encountered	depth	
	from	to
Red Clay	0	20
Red sand	20	80
White sand	80	132

WELL LOCATION:  
sec. 34 T. 3 N R. 5 E  
2 miles W of W. also  
(distance) (direction) (nearest town)

WELL PURPOSE: home  
(home, irrigation, municipal, industrial)

WELL COMPLETION DATA:  
(1) diameter (inches) 4 in  
(2) total depth (feet) 132  
(3) static water level (feet) \_\_\_\_\_ below above top of ground.  
(4) casing Plastic 132 (material) (depth)  
(size) if telescope see back.  
(5) screen 7 ft 125 (length) (depth to top)  
4 in Gravel (size) (material)  
(6) pump 1/2 10 (HP) (yield gpm)  
220 (type power)  
(7) electric log No (yes or no)  
(organization running log)  
(8) how well bottom plugged Cap

DRILLERS REMARKS:


Miss. Board of Water Comm.

JUL 12 1979

RECEIVED

If well telescopes please sketch and show depths.

GROUND LEVEL

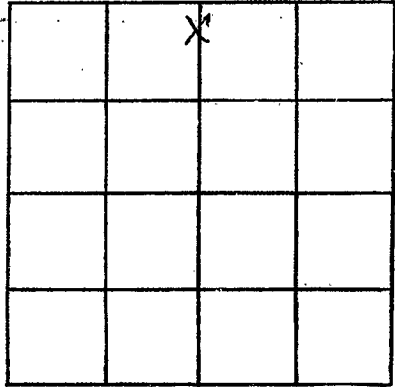

SECTION 3

Please indicate well location X.

ADDITIONAL INFORMATION

A series of horizontal lines for recording additional information.

If more than one screen, show locations of each on sketch.