

MARSHALL
H 2029
8/01/79

MISSISSIPPI
BOARD OF WATER COMMISSIONERS
416 North State Street
Jackson, Mississippi 39201

WATER WELL DRILLERS LOG

8-1-1979 Nichols Wells Marshall
 date well completed firm name county well located

LANDOWNER:
Dimmy Davis
Rt. 4, Bayholie Miss.
 (mailing address)

description of formations encountered	from	to
Clay	0	20
Red sand	20	70
White sand	70	155

WELL LOCATION:
 sec. 36 T. 3 N. R. 5 E.
1/2 miles S of Winston
 (distance) (direction) (nearest town)

WELL PURPOSE: home
 (home, irrigation, municipal, industrial)

WELL COMPLETION DATA:

(1) diameter (inches) 4 in

(2) total depth (feet) 155

(3) static water level (feet) _____ below above top of ground.

(4) casing Plastic 155
 (material) (depth)

_____ if telescope see back.
 (size)

(5) screen 2 ft, 148
 (length) (depth to top)

4 in, bravel
 (size) (material)

(6) pump 1/2 10
 (HP) (yield gpm)

220
 (type power)

(7) electric log No
 (yes or no)

_____ (organization running log)


(8) how well bottom plugged Cap

Miss. Board of Water Comm
 AUG 27 1979
 RECEIVED

DRILLERS REMARKS:

If well telescopes please sketch and show depths.

GROUND LEVEL

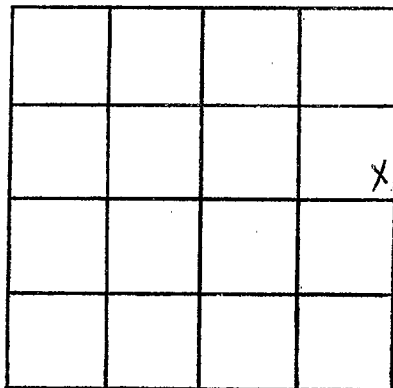

SECTION 36

Please indicate well location X.

ADDITIONAL INFORMATION

If more than one screen,
show locations of each on sketch.