

Marshall
H 2030
5-13-80

MISSISSIPPI
BOARD OF WATER COMMISSIONERS
416 North State Street
Jackson, Mississippi 39201

WATER WELL DRILLERS LOG

4-30 1980 Rich Wells Marshall
date well completed firm name county well located

LANDOWNER:
Williams Devoes
Rt. 3, Bynahia Miss
(mailing address)

description of formations encountered	depth	
	from	to
Clay	0	20
red sand	20	90
white sand	90	142

WELL LOCATION:
sec 24 T-3 N R-5 E
1 miles N of Watauga
(distance) (direction) (nearest town)

WELL PURPOSE: home
(home, irrigation, municipal, industrial)

WELL COMPLETION DATA:
(1) diameter (inches) 4 in
(2) total depth (feet) 142
(3) static water level (feet) 80 below top of ground
(4) casing 4" pipe 142 (material) (depth)
(size) if telescope see back.
(5) screen 7 ft, 135 (length) (depth to top)
4 in, Gravel (size) (material)
(6) pump 1/2 HP, 10 (yield gpm)
220 (type power)
(7) electric log No (yes or no)
(organization running log)
(8) how well bottom plugged Cap

DRILLERS REMARKS:


DEPT. OF NATURAL RESOURCES
BUREAU OF LAND & WATER RESOURCES

MAY 12 1980

RECEIVED

If well telescopes please sketch and show depths.

GROUND LEVEL

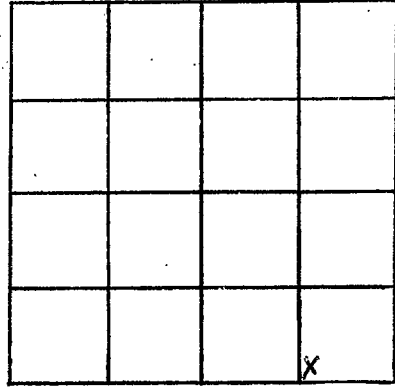

SECTION 24

Please indicate well location X.

ADDITIONAL INFORMATION

If more than one screen,
show locations of each on sketch.