

Marshall

H 2031

6-16-80  
6-16

MISSISSIPPI  
BOARD OF WATER COMMISSIONERS  
416 North State Street  
Jackson, Mississippi 39201

WATER WELL DRILLERS LOG

1980 Walter Guy Co.

De Soto  
Marshall

date well completed

firm name

county well located

LANDOWNER:  
Walter Guy  
Bayhalla  
(mailing address)

description of formations encountered	from	to
clay	0	30
red sand	30	110
white sand	110	155

WELL LOCATION:  
sec. 5 T 3 N R 5 E  
1 miles E of Bayhalla  
(distance) (direction) (nearest town)

WELL PURPOSE: home  
(home, irrigation, municipal, industrial)

WELL COMPLETION DATA:

(1) diameter (inches) 4 in

(2) total depth (feet) 155

(3) static water level (feet) 100 below above top of ground.

(4) casing Plastic 155 (material) (depth)

(size) if telescope see back.

(5) screen 7ft 148 (length) (depth to top)  
4 in Gravel (size) (material)

(6) pump 1/2 10 (HP) (yield gpm)  
220 (type power)

(7) electric log No (yes or no)

(organization running log)

(8) how well bottom plugged Cap


DRILLERS REMARKS:

DEPT. OF NATURAL RESOURCES  
BUREAU OF LAND & WATER RESOURCES

JUN 25 1980  
RECEIVED

If well telescopes please sketch and show depths.

GROUND LEVEL

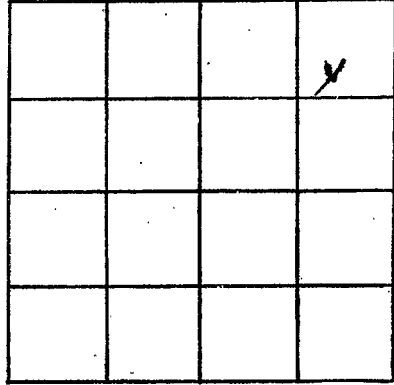

SECTION 5

Please indicate well location X.

ADDITIONAL INFORMATION

If more than one screen,  
show locations of each on sketch.