

MARSHALL
H 2032
9-2-80

MISSISSIPPI
BOARD OF WATER COMMISSIONERS
416 North State Street
Jackson, Mississippi 39201

WATER WELL DRILLERS LOG

9-2 19 80 So. Hill Well Co. Marshall
date well completed firm name county well located

LANDOWNER: <u>Ralph Woods</u>	description of formations encountered	from	to
<u>Wissaw</u>			
<u>Bishop, Ms.</u> (mailing address)	<u>Clay</u>	<u>0</u>	<u>30</u>
WELL LOCATION: sec. <u>12</u> T <u>3</u> N R <u>5</u> E _____ miles _____ of <u>Wissaw</u> (distance) (direction) (nearest town)	<u>White Sand</u>	<u>30</u>	<u>165</u>
WELL PURPOSE: <u>Sub. Domestic</u> (home, irrigation, municipal, industrial)			
WELL COMPLETION DATA:			
(1) diameter (inches) <u>4"</u>			
(2) total depth (feet) <u>165</u>			
(3) static water level (feet) <u>130</u> below top of ground.			
(4) casing <u>PVC</u> , <u>165</u> (material) (depth)			
_____ (size) if telescope see back.			
(5) screen <u>7'</u> , <u>158</u> (length) (depth to top)			
(6) pump <u>4"</u> , <u>granite type</u> (size) (material)			
(6) pump <u>1 1/2</u> , <u>25</u> (HP) (yield gpm)			
(6) pump <u>200V</u> (type power)			
(7) electric log <u>No</u> (yes or no)			
_____ (organization running log)			
(8) how well bottom plugged <u>Cap</u>			

DRILLERS REMARKS:


DEPT. OF NATURAL RESOURCES
BUREAU OF LAND & WATER RESOURCES

SEP 29 1980

RECEIVED

If well telescopes please sketch and show depths.

GROUND LEVEL

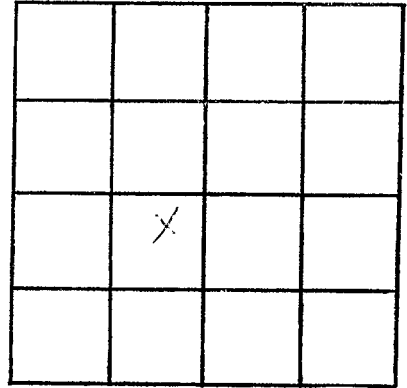

SECTION 12

Please indicate well location X.

ADDITIONAL INFORMATION

If more than one screen,
show locations of each on sketch.