

Marshall  
H  
2034

MISSISSIPPI DEPARTMENT OF NATURAL RESOURCES  
Bureau of Land and Water Resources  
Southport Mall  
P.O. Box 10631

Jackson, Mississippi 39209

WATER WELL DRILLERS LOG

HICKS WELL CO.  
Rt. 1, Box 157

Marshall

7-30 1982  
date well completed

Senatobia, MS 38668

county well located

LANDOWNER: Curtis Surley  
1/2 Surley Tool & Pie Co  
Byhalia, Miss. 38611  
(mailing address)

| description of formations encountered | from | to  |
|---------------------------------------|------|-----|
| Red Clay                              | 0    | 20  |
| Red Sand                              | 20   | 50  |
| Blue Clay                             | 50   | 85  |
| White Sand & Clay                     | 85   | 130 |
| White Sand                            | 130  | 158 |

WELL LOCATION:  
sec. 23 T. 3 N. R. 5 E  
1 1/2 miles N of Watson  
(distance) (direction) (nearest town)

WELL PURPOSE: Home  
(home, irrigation, municipal, industrial)

- WELL COMPLETION DATA:
- (1) diameter (inches) 4
  - (2) total depth (feet) 158
  - (3) static water level (feet) 40 below top of ground.
  - (4) casing PVC, 158 (material), (depth)  
4" (size) if telescope see back.
  - (5) screen 15' (length), 143' (depth to top)  
013 (size), PVC (material)
  - (6) pump 2 (HP), 28 (yield gpm)  
220V (type power)
  - (7) electric log No (yes or no)  
(organization running log)
  - (8) how well bottom plugged Cap


MISSISSIPPI DEPARTMENT OF NATURAL RESOURCES  
BUREAU OF LAND & WATER RESOURCES

AUG - 4 1982  
RECEIVED

DRILLERS REMARKS:

If well telescopes please sketch and show depths.

GROUND LEVEL

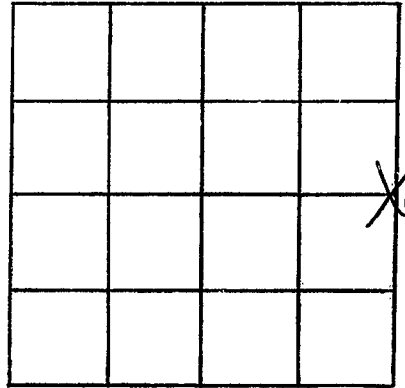

SECTION 23

Please indicate well location X.

ADDITIONAL INFORMATION

If more than one screen,  
show locations of each on sketch.