

MISSISSIPPI DEPARTMENT OF NATURAL RESOURCES

Bureau of Land and Water Resources

Southport Mall

P.O. Box 10631

Jackson, Mississippi 39209

WATER WELL DRILLERS LOG

MARSHALL  
H 2036  
3-25-83

March 25

19 83

Earl Jones Well Co

Marshall

date well completed

firm name

county well located

LANDOWNER:

Jimmy Thompson  
Byhalia Miss. RT.  
(mailing address)

description of formations encountered

from to

Topsoil & clay sand	0	14
gravel sand - clay	14	26
sand	26	32
clay	32	65
sand	65	85
clay	85	90
sand	90	97
	97	<u>145</u>

WELL LOCATION:

sec. 35 T 3 N R 5 E  
S W  
1/2 miles W. of Watson  
(distance) (direction) (nearest town)

WELL PURPOSE:

Home  
(home, irrigation, municipal, industrial)

WELL COMPLETION DATA:

- (1) diameter (inches) 4"
- (2) total depth (feet) 145
- (3) static water level (feet) 80 ~~above~~ below top of ground.
- (4) casing plastic 135  
(material) (depth)  
4" if telescope see back.  
(size)
- (5) screen 10' 135  
(length) (depth to top)  
4"-013 plastic  
(size) (material)
- (6) pump 3/4 15  
(HP) (yield gpm)  
electric  
(type power)
- (7) electric log no  
(yes or no)

(organization running log)

(8) how well bottom plugged plastic cap

DRILLERS REMARKS:


DEPT. OF NATURAL RESOURCES  
BUREAU OF LAND & WATER RESOURCES

MAY 18 1983

RECEIVED

If well telescopes please sketch and show depths.

GROUND LEVEL

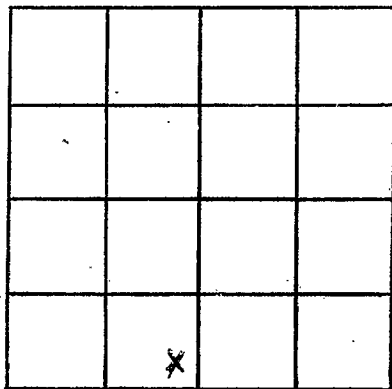

SECTION 35

Please indicate well location X.

ADDITIONAL INFORMATION

If more than one screen, show locations of each on sketch.