

MISSISSIPPI DEPARTMENT OF NATURAL RESOURCES

Bureau of Land and Water Resources

Southport Mall

P.O. Box 10631

Jackson, Mississippi 39209

WATER WELL DRILLERS LOG

HICKS WELL CO.

Rt. 1, Box 157

Senatobia, MS 38668

Marshall

Marshall
H
2037

1/4 1984
date well completed

Marshall county well located

LANDOWNER: Roy Stevenson
P.O. 2 Box 120 C
Brykaler, Ms. 38611
(mailing address)

description of formations encountered	from	to
Red Clay	0	10
Red Sand	10	30
white Clay + Sand	30	110
white Sand	110	140

WELL LOCATION:
sec. 25 T 3 N R 5 E
1/2 miles N of Watson
(distance) (direction) (nearest town)

WELL PURPOSE: Home
(home, irrigation, municipal, industrial)

WELL COMPLETION DATA:

(1) diameter (inches) 4

(2) total depth (feet) 140

(3) static water level (feet) 75 below above top of ground.

(4) casing PVC 140 (material), (depth)
4" (size) if telescope see back.

(5) screen 10' 130 (length), (depth to top)
1.010 PVC (size), (material)

(6) pump 1/2 10 (HP), (yield gpm)
220V (type power)

(7) electric log NO (yes or no)
NO (organization running log)

(8) how well bottom plugged Cap

DRILLERS REMARKS:


DEPT. OF NATURAL RESOURCES
BUREAU OF LAND & WATER RESOURCES

JAN 30 1984

RECEIVED

If well telescopes please sketch and show depths.

GROUND LEVEL

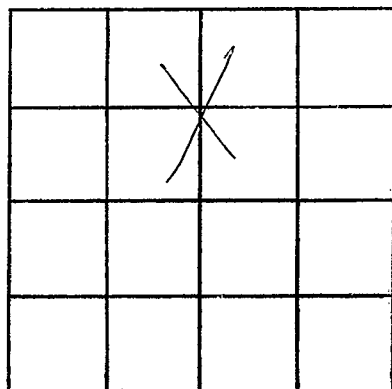

SECTION 25

Please indicate well location X.

ADDITIONAL INFORMATION

If more than one screen, show locations of each on sketch.