

MISSISSIPPI DEPARTMENT OF NATURAL RESOURCES

Bureau of Land and Water Resources

Southport Mall

P.O. Box 10631

Jackson, Mississippi 39209

WATER WELL DRILLERS LOG

Marshall  
H  
2038

date well completed 3/26 1984 firm name HICKS WELL CO. county Marshall  
Rt. 1, Box 157  
Senatobia, MS 38668 well located

LANDOWNER: Charles Brecher Sr.  
Rt. 5 Box 21  
Byhalia, Ms. 38611  
(mailing address)

| description of formations encountered | from       | to         |
|---------------------------------------|------------|------------|
| <u>Red Clay</u>                       | <u>0</u>   | <u>20</u>  |
| <u>Red Sand</u>                       | <u>20</u>  | <u>50</u>  |
| <u>White Sand &amp; Clay</u>          | <u>50</u>  | <u>110</u> |
| <u>White Sand</u>                     | <u>110</u> | <u>135</u> |
| <u>Black Clay</u>                     | <u>135</u> | <u>150</u> |
| <u>White Sand</u>                     | <u>150</u> | <u>162</u> |

WELL LOCATION:  
sec. 25 T 3 N R 5 E  
1 miles NE of Watson  
(distance) (direction) (nearest town)

WELL PURPOSE: Home  
(home, irrigation, municipal, industrial)

WELL COMPLETION DATA:

(1) diameter (inches) 4

(2) total depth (feet) 162

(3) static water level (feet) 90 below above top of ground.

(4) casing PVC 162  
(material) (depth)

         if telescope see back.  
(size)

(5) screen 25' 130  
(length) (depth to top)

010 PVC  
(size) (material)

(6) pump 1/2 10  
(HP) (yield gpm)

220V  
(type power)

(7) electric log No  
(yes or no)

          
(organization running log)

(8) how well bottom plugged Cap

DRILLERS REMARKS:

DEPT. OF NATURAL RESOURCES  
BUREAU OF LAND & WATER RESOURCES

APR 16 1984


RECEIVED

If well telescopes please sketch and show depths.

GROUND LEVEL

130' - 4" 160

13'-8-2" 200 lbs  
11'-2" 500 lbs  
4'-10" 500 lbs  
10' 500 lbs  
Cap

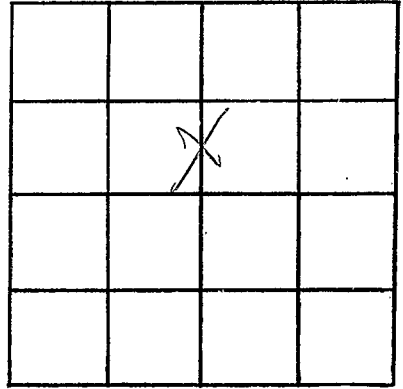

SECTION 25

Please indicate well location X.

ADDITIONAL INFORMATION

If more than one screen, show locations of each on sketch.