

MISSISSIPPI DEPARTMENT OF NATURAL RESOURCES

Bureau of Land and Water Resources

Southport Mall

P.O. Box 10631

Jackson, Mississippi 39209

WATER WELL DRILLERS LOG

Marshall
H
2039

6-19-84 date well completed Wilson Well Co. Inc. firm name Marshall county well located

LANDOWNER: George McAlister
Rt 2 Box 35 B
Byhalia, Ms. 38611
 (mailing address)
 WELL LOCATION:
 sec 13 T 3 N R 5 E
3 miles SE of Byhalia
 (distance) (direction) (nearest town)

description of formations encountered	from	to
Brown Clay	0	20
Brown Sand	20	45
White Sand	45	60
White Clay	60	64
White Sand	64	125

WELL PURPOSE: Home
 (home, irrigation, municipal, industrial)

- WELL COMPLETION DATA:
- (1) diameter (inches) 4
 - (2) total depth (feet) 105
 - (3) static water level (feet) 25 below top of ground.
 - (4) casing Plastic, 105
 (material) (depth)
4 if telescope see back.
 (size)
 - (5) screen 10, Plastic
 (length) (depth to top)
4, Plastic
 (size) (material)
 - (6) pump 3/4, 10
 (HP) (yield gpm)
Elec
 (type power)
 - (7) electric log no
 (yes or no)
 (organization running log)
 - (8) how well bottom plugged 1/2 PVC cap

DRILLERS REMARKS:


DEPT OF NATURAL RESOURCES
 BUREAU OF LAND & WATER RESOURCES

SEP 20 1984

RECEIVED

If well telescopes please
sketch and show depths.

GROUND LEVEL

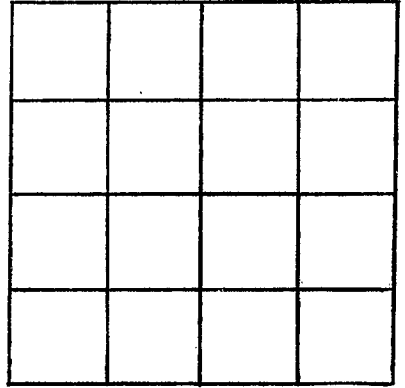

SECTION _____

Please indicate well location X.

ADDITIONAL INFORMATION

If more than one screen,
show locations of each on sketch.