

MISSISSIPPI DEPARTMENT OF NATURAL RESOURCES

Bureau of Land and Water Resources

Southport Mall

P.O. Box 10631

Jackson, Mississippi 39209

WATER WELL DRILLERS LOG

Marshall
H 2040
3-30-85

3-30-85
 date well completed

HICKS WELL CO.
 Firm name
 Searsville, La 70450

Marshall
 county well located

LANDOWNER: Troy Jones

description of formations encountered

from

to

Rt #2 Box 120V

Red clay

0

10

Byhalia MS 38611
 (mailing address)

Red sand

10

30

White sand & clay

30

60

White sand

60

140

WELL LOCATION:

sec. 24 T 3 N R 5 E
 (S) (W)
1 miles North of Watson
 (distance) (direction) (nearest town)

WELL PURPOSE: Home
 (home, irrigation, municipal, industrial)

WELL COMPLETION DATA:

(1) diameter (inches) 4"
 (2) total depth (feet) 140"
 (3) static water level (feet) 100' ^{below} _{above}
 top of ground.

(4) casing PVC, 130'
 (material) (depth)
4"
 (size) if telescope see back.

(5) screen 10', 130'
 (length) (depth to top)

.010, PVC
 (size) (material)

(6) pump 1/2, 10
 (HP) (yield gpm)
220 Electric
 (type power)

(7) electric log No
 (yes or no)

(organization running log)

(8) how well bottom plugged Cap

DRILLERS REMARKS:


RECEIVED

JUL 1 - 1985

Department of Natural Resources
 Bureau of Land & Water Resources

If well telescopes please sketch and show depths.

GROUND LEVEL

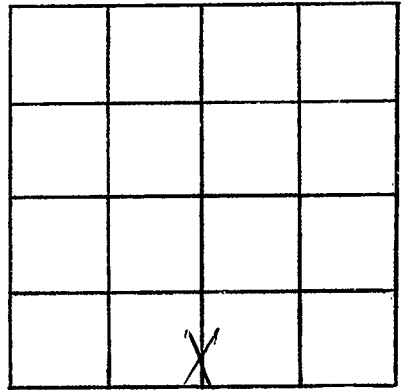

SECTION 27

Please indicate well location X.

ADDITIONAL INFORMATION

If more than one screen,
show locations of each on sketch.