

MISSISSIPPI DEPARTMENT OF NATURAL RESOURCES

Bureau of Land and Water Resources

Southport Mall

P.O. Box 10631

Jackson, Mississippi 39209

WATER WELL DRILLERS LOG

H 2041  
Marshall  
226-85

#4550

2-26 1985 Garner House Well Co. Marshall  
date well completed firm name county well located

LANDOWNER: David Hendrickson  
Rt 2 Box 31 E  
Byhalia, Miss 38611  
(mailing address)

description of formations encountered	from	to
Brown Clay	0	15
Red Sand	15	65
White Clay	65	85
White Sand	85	125

WELL LOCATION:  
sec. 11 T-3 N R-5 E  
S W  
1/2 miles N of Warsaw  
(distance) (direction) (nearest town)

WELL PURPOSE:  
(home) Irrigation, municipal, industrial

- WELL COMPLETION DATA:
- (1) diameter (inches) 4
  - (2) total depth (feet) 125
  - (3) static water level (feet) 85 below above top of ground.
  - (4) casing plastic, 115  
(material) (depth)  
         if telescope see back.  
(size)
  - (5) screen 10, 115  
(length) (depth to top)  
4, Plastic  
(size) (material)
  - (6) pump 1, 20  
(HP) (yield gpm)  
electric  
(type power)
  - (7) electric log (yes or no)           
          
(organization running log)
  - (8) how well bottom plugged 4" 11  
Plastic log


RECORDED  
SEP 20 1985

DRILLERS REMARKS:

Department of Natural Resources  
Bureau of Land & Water Resources

If well telescopes please sketch and show depths.

GROUND LEVEL

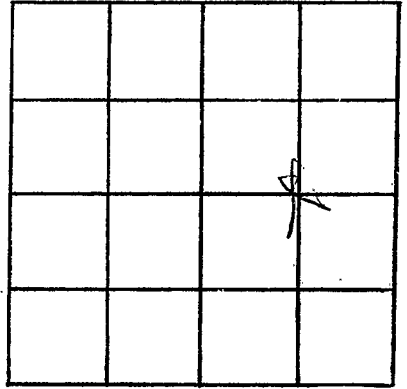

SECTION 11

Please indicate well location X.

ADDITIONAL INFORMATION

If more than one screen,  
show locations of each on sketch.