

MISSISSIPPI DEPARTMENT OF NATURAL RESOURCES

Bureau of Land and Water Resources

Southport Mall

P.O. Box 10631

Jackson, Mississippi 39209

WATER WELL DRILLERS LOG

MARSHALL
H 2043

Oct. 2 1985 Larry Carpenter Well Co Marshall
date well completed firm name county well located

LANDOWNER: Phil Malone
Byhalia, Ms.

(mailing address)

WELL LOCATION:

sec 6 T 3 N R 5 E
S W
1 miles East of Byhalia
(distance) (direction) (nearest town)

WELL PURPOSE: None
(home, irrigation, municipal, industrial)

WELL COMPLETION DATA:

- (1) diameter (inches) 4
- (2) total depth (feet) 180
- (3) static water level (feet) 40 below above top of ground.
- (4) casing PVC, 170',
(material) (depth)
____ if telescope see back.
(size)
- (5) screen 10", 170'
(length) (depth to top)
4", PVC
(size) (material)
- (6) pump 1/2, 10
(HP) (yield gpm)
Elex
(type power)
- (7) electric log No.
(yes or no)

(organization running log)


(8) how well bottom plugged PVC Cap

description of formations encountered

from

to

<u>Surface Soil</u>	<u>0</u>	<u>15</u>
<u>White Clay</u>	<u>15</u>	<u>55</u>
<u>White coarse Sand</u>	<u>55</u>	<u>80</u>
<u>Fine white Sand</u>	<u>80</u>	<u>130</u>
<u>White Clay</u>	<u>130</u>	<u>140</u>
<u>White med. Sand</u>	<u>140</u>	<u>180</u>

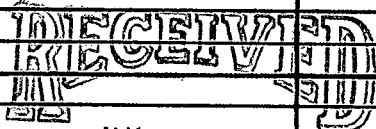

JUL 23 1986

Department of Natural Resources
Bureau of Land & Water Resources

DRILLERS REMARKS:

If well telescopes please sketch and show depths.

GROUND LEVEL

		X	

SECTION 6

Please indicate well location X.

ADDITIONAL INFORMATION

If more than one screen, show locations of each on sketch.