

MISSISSIPPI DEPARTMENT OF NATURAL RESOURCES

Bureau of Land and Water Resources

Southport Mall

P.O. Box 10631

Jackson, Mississippi 39209

WATER WELL DRILLERS LOG

MARSHALL  
H2044

4-29 1984 Bullet Water Well Marshall  
date well completed firm name county well located

LANDOWNER: B. J. Stewart  
1939 Nellie  
Memphis, Tenn. 38116  
(mailing address)

description of formations encountered	from	to
<u>Red Clay</u>	<u>0</u>	<u>15'</u>
<u>Red sand &amp; gravel</u>	<u>15'</u>	<u>40'</u>
<u>white sand &amp; clay</u>	<u>40'</u>	<u>100'</u>
<u>white sand</u>	<u>100'</u>	<u>140'</u>

WELL LOCATION:  
sec. 11 T. 3 N. R. 5 E.  
1/2 miles East of Warren  
(distance) (direction) (nearest town)

WELL PURPOSE: home  
(home, irrigation, municipal, industrial)

WELL COMPLETION DATA:

(1) diameter (inches) 4"

(2) total depth (feet) 140'

(3) static water level (feet) 100' <sup>below</sup> above top of ground.

(4) casing PVC, 130',  
(material) (depth)  
4" If telescope see back.  
(size)

(5) screen 10', 140'  
(length) (depth to top)  
4", PVC  
(size) (material)

(6) pump 3/4, 10  
(HP) (yield gpm)  
Elec.  
(type power)

(7) electric log No  
(yes or no)

(organization running log)

(8) how well bottom plugged Cap




AUG 11 1984

Department of Natural Resources  
Bureau of Land & Water Resources

DRILLERS REMARKS:

If well telescopes please sketch and show depths.

GROUND LEVEL

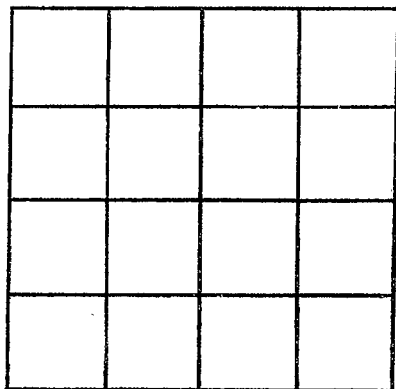

SECTION \_\_\_\_\_

Please indicate well location X.

ADDITIONAL INFORMATION

If more than one screen, show locations of each on sketch.