

MISSISSIPPI DEPARTMENT OF NATURAL RESOURCES

Bureau of Land and Water Resources

Southport Mall

P.O. Box 10631

Jackson, Mississippi 39209

WATER WELL DRILLERS LOG

Marshall  
H  
2045

6-16 date well completed      1986 Sweetwater Well Marshall firm name      county well located

LANDOWNER: Cecil Brown  
Rt 4 Box 663  
Birmingham, AL  
 (mailing address)

description of formations encountered	from	to
<u>Red Clay</u>	<u>0</u>	<u>10</u>
<u>Red sand &amp; clay</u>	<u>10</u>	<u>30</u>
<u>White sand &amp; clay</u>	<u>30</u>	<u>100</u>
<u>White sand</u>	<u>100</u>	<u>150</u>

WELL LOCATION:  
 sec. 7 T. 3 N. R. 4 E.  
2 miles South of Warsaw  
 (distance) (direction) (nearest town)

WELL PURPOSE: Home  
 (home, irrigation, municipal, industrial)

- WELL COMPLETION DATA:
- (1) diameter (inches) 4"
  - (2) total depth (feet) 150
  - (3) static water level (feet) 75 below top of ground.
  - (4) casing PVC 140'  
 (material) (depth)  
4" if telescope see back.  
 (size)
  - (5) screen 10' 140'  
 (length) (depth to top)  
4" PVC  
 (size) (material)
  - (6) pump 1/2 10  
 (HP) (yield gpm)  
Elec  
 (type power)
  - (7) electric log No  
 (yes or no)
- (organization running log)
- (8) how well bottom plugged Cap


RECEIVED  
 AUG 11 1986

DEPARTMENT OF NATURAL RESOURCES  
 BUREAU OF LAND & WATER RESOURCES

DRILLERS REMARKS:

If well telescopes please sketch and show depths.

GROUND LEVEL

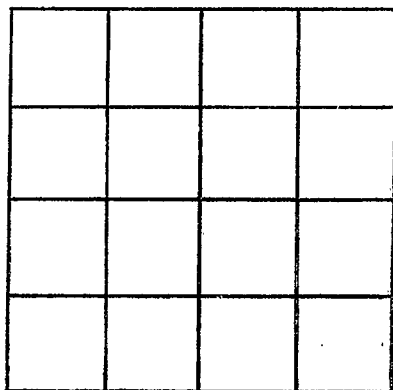

SECTION \_\_\_\_\_

Please indicate well location X.

ADDITIONAL INFORMATION

If more than one screen,  
show locations of each on sketch.