

MISSISSIPPI DEPARTMENT OF NATURAL RESOURCES

Bureau of Land and Water Resources

Southport Mall

P.O. Box 10631

Jackson, Mississippi 39209

WATER WELL DRILLERS LOG

Marshall
H
2047

6-21 1986 Sullett Water Well Marshall
 date well completed firm name county well located

LANDOWNER: Bobby Rogers
Rt 3
Byhalia, Mo
 (mailing address)

description of formations encountered

from	to
0'	15'
15'	40'
40'	80'
80'	120'

Clay
Red sand & clay
White sand & clay
White sand

WELL LOCATION:
 sec 3 T 3 N R 5 E
2 miles SW of Byhalia
 (distance) (direction) (nearest town)

WELL PURPOSE: home
 (home, irrigation, municipal, industrial)

WELL COMPLETION DATA:

(1) diameter (inches) 4"

(2) total depth (feet) 120'

(3) static water level (feet) 75' below above top of ground.

(4) casing PVC, 110
 (material) (depth)
4" if telescope see back.
 (size)

(5) screen 10', 110'
 (length) (depth to top)
4", PVC
 (size) (material)

(6) pump 3/4, 10
 (HP) (yield gpm)
Elec
 (type power)

(7) electric log No
 (yes or no)

(organization running log)

(8) how well bottom plugged Cap


RECEIVED
 AUG 11 1986

Department of Natural Resources
 Bureau of Land and Water Resources

DRILLERS REMARKS:

If well telescopes please sketch and show depths.

GROUND LEVEL

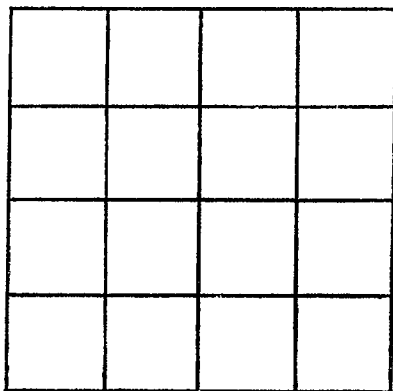

SECTION _____

Please indicate well location X.

ADDITIONAL INFORMATION

If more than one screen,
show locations of each on sketch.