

MISSISSIPPI DEPARTMENT OF NATURAL RESOURCES

Bureau of Land and Water Resources

Southport Mall

P.O. Box 10631

Jackson, Mississippi 39209

WATER WELL DRILLERS LOG

Marshall  
H  
2048

7-18

date well completed

1986 Sweet Water Well

firm name

Marshall

county well located

LANDOWNER: Ken Franklin

description of formations encountered.

from to,

Byhalia, Mo  
 (mailing address)

<u>Top Soil</u>	<u>0'</u>	<u>2'</u>
<u>Red Clay</u>	<u>2'</u>	<u>15'</u>
<u>Red sand &amp; gravel</u>	<u>15'</u>	<u>40'</u>
<u>White sand &amp; clay</u>	<u>40'</u>	<u>100'</u>
<u>White sand</u>	<u>100'</u>	<u>135'</u>


WELL LOCATION:

sec 34 T 3 N R. 5 E  
4 miles West of Watson  
 (distance) (direction) (nearest town)

WELL PURPOSE: home  
 (home, irrigation, municipal, industrial)

WELL COMPLETION DATA:

- (1) diameter (inches) 4"
- (2) total depth (feet) 135'
- (3) static water level (feet) 70 <sup>(below)</sup> <sub>(above)</sub> top of ground.
- (4) casing PVC, 125'  
 (material) (depth)  
4" If telescope see back.  
 (size)
- (5) screen 10', 125'  
 (length) (depth to top)  
4" PVC  
 (size) (material)
- (6) pump 3/4, 10  
 (HP) (yield gpm)  
Elec  
 (type power)
- (7) electric log No  
 (yes or no)  
 (organization running log)
- (8) how well bottom plugged Cap

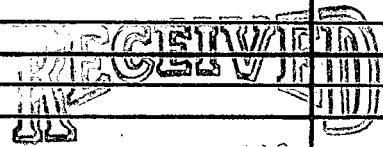


AUG 11 1986

Department of Natural Resources  
 Bureau of Land & Water Resources

DRILLERS REMARKS:

If well telescopes please sketch and show depths.

GROUND LEVEL

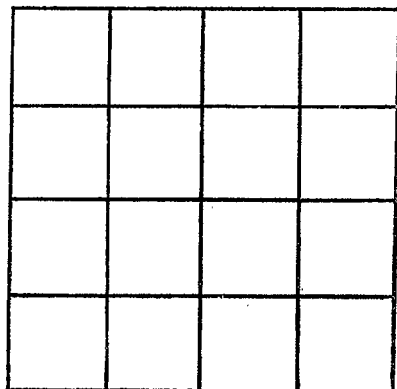

SECTION \_\_\_\_\_

Please indicate well location X.

ADDITIONAL INFORMATION

If more than one screen, show locations of each on sketch.