

**MISSISSIPPI DEPARTMENT OF NATURAL RESOURCES**

Bureau of Land and Water Resources

COUNTY WELL LOCATED <i>Marshall</i>	
WELL NUMBER <i>H 2057</i>	CODED
DATE WELL COMPLETED <i>6-9-88</i>	

PERMIT NUMBER <i>HICKS WELL COMPANY</i>
NAME OF DRILLING FIRM <i>RT. 1 - BOX 157</i>
<i>SENATOBIA, MISS.</i>

P.O. Box 10631  
Jackson, Mississippi 39209  
WATER WELL DRILLERS LOG

NAME & MAILING ADDRESS OF LANDOWNER <i>Willie BUNSON</i>			
<i>RT. 4</i>			
<i>By hand</i>			
WELL LOCATION: SEC	TOWNSHIP	RANGE	
<i>30</i>	<i>3</i>	<i>N</i> <i>(S)</i>	<i>5</i> <i>(W)</i>
DISTANCE	DIRECTION	NEAREST TOWN	
<i>2</i> Miles	<i>E</i>	<i>WATSON</i>	
OTHER LANDMARK			
WELL PURPOSE: <input checked="" type="radio"/> Home Irrigation, Municipal, Industrial, Fish Pond, etc.			

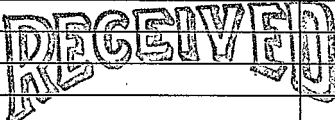
<b>PUMP DATA</b>		
PUMP TYPE (Circle One): <input checked="" type="radio"/> Submersible, Turbine, Jet, Flowing Well, Other (Describe) _____		
POWER TYPE (Circle One): Electric, Tractor, Diesel, Gasoline, Butane, Other (Describe) _____		
Pump Capacity (GPM) <i>10</i>	No. of Stages <i>9</i>	Setting Depth <i>130</i> FT.
PUMP TEST		
Well yielded <i>10</i> GPM with a drawdown of _____ ft. after _____ hours of pumping		

<b>WELL DATA</b>		
Well Depth <i>160</i>	Casing Diameter (In.) <i>4"</i>	Casing Length (Ft.) <i>150</i>
Type of Casing <i>PVC</i>	Hole Depth <i>6"</i>	Depth to Static Water Level <i>120</i>
TYPE OF COMPLETION: (Circle One or More): <input checked="" type="radio"/> Gravel Packed, Underreamed, Telescoped, Natural Development, Open Hole, Other (Describe) _____		
Top of Lap Pipe or Reduction in Casing FEET <input type="checkbox"/> IF TELESCOPED OR MORE THAN ONE SCREEN: USE BACK PAGE		

<b>LOG DATA</b>	
TYPE OF LOG RUN (Circle One): No Log Run, Electric, Gamma Ray, Density, Sonic, Neutron, Other (Describe) _____	
Name of Organization Running Log	

<b>SCREEN DATA</b>		
Diameter - Inches <i>4"</i>	Length - Feet <i>10</i>	Slot Size - Inches <i>013</i>
Screen Type <i>PVC</i>		Depth to Bottom - Feet

<b>GEOLOGIC DATA (Office Use Only)</b>			
Surface Elev.	Geologic Unit	Unit Thickness	Depth to Top
Subs. SWL	Date	Analysis	Aquifer Test
Driller's Remarks			

DESCRIPTION OF FORMATIONS ENCOUNTERED	FROM	TO	FORMATIONS (Continued)	FROM	TO
<i>R. C</i>	<i>0</i>	<i>30</i>	 <i>JUN 28 1988</i>		
<i>R. S.</i>	<i>30</i>	<i>90</i>			
<i>W.S.</i>	<i>90</i>	<i>160</i>			
			Department of Natural Resources Bureau of Land & Water Resources		
IF MORE SPACE IS NEEDED, USE BACK					

If well telescopes please sketch and show depths.

GROUND LEVEL

X			

SECTION 30

Please indicate well location X.

ADDITIONAL INFORMATION

If more than one screen,  
show location of each on sketch.