

MARSHALL

~~5~~ 5

7-11-78

MISSISSIPPI
BOARD OF WATER COMMISSIONERS
416 North State Street
Jackson, Mississippi 39201

WATER WELL DRILLERS LOG

7-11
date well completed

1978 *Dean Kent Sufrostek*
firm name

Marshall
county well located

LANDOWNER:	description of formations encountered	from	to
<i>Tommy Shaufner</i>			
<i>Holly Slings, miss</i> (mailing address)	<i>Sand</i>	<i>30</i>	<i>170</i>
WELL LOCATION:			
sec. <i>35</i> T <i>3</i> N R <i>4</i> E W			
<i>7</i> miles <i>West</i> of <i>H.S.</i>			
(distance) (direction) (nearest town)			
WELL PURPOSE: <i>Drillers</i> (home, irrigation, municipal, industrial)			
WELL COMPLETION DATA:			
(1) diameter (inches)	<i>4"</i>		
(2) total depth (feet)	<i>170 feet</i>		
(3) static water level (feet)	<i>112</i> below top of ground.		
(4) casing (material)	<i>PVC</i> , <i>170 feet</i> (depth)		
(size)	If telescope see back.		
(5) screen (length)	<i>24'</i> , <i>163 feet</i> (depth to top)		
(size)	<i>4"</i> , <i>gravel wash</i> (material)		
(6) pump (HP)	<i>3/4</i> , <i>14</i> (yield gpm)		
(type power)			
(7) electric log (yes or no)	<i>Yes</i>		
(organization running log)			
(8) how well bottom plugged	<i>4' cap</i>		


RECEIVED

AUG 14 1978

DRILLERS REMARKS:

If well telescopes please sketch and show depths.

GROUND LEVEL

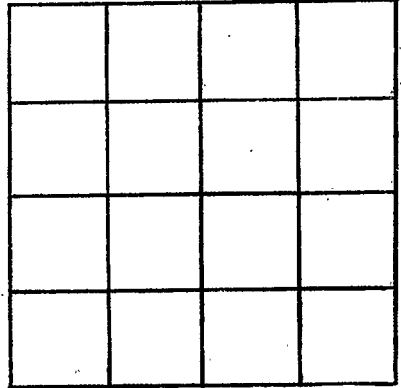

SECTION _____

Please indicate well location X.

ADDITIONAL INFORMATION

If more than one screen,
show locations of each on sketch.