


If well telescopes please sketch and show depths.

GROUND LEVEL

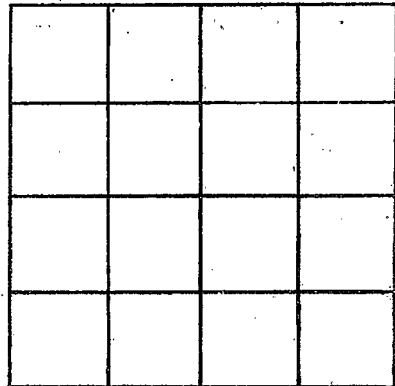

SECTION _____

Please indicate well location X.

ADDITIONAL INFORMATION

If more than one screen,
show locations of each on sketch.

MARSHALL

52

4-26-71

MISSISSIPPI BOARD OF WATER COMMISSIONERS 416 North State Street Jackson, Mississippi 39201

CODED

WATER WELL DRILLERS LOG

4-26-71 date well completed 71 Dean Kent Burges wells firm name Marshall county well located

LANDOWNER:	description of formations encountered	from	to
Artha R. Pannell		clay	0
St. 3, Ophalia, Miss. (mailing address)	sand	10	70
WELL LOCATION:	clay	70	90
sec. 36 T 3 N R 4 E (distance) miles (direction) of (nearest town)	sand	90	210
WELL PURPOSE: <u>Swimming</u> (home, irrigation, municipal, industrial)			
WELL COMPLETION DATA:			
(1) diameter (inches) <u>4"</u>			
(2) total depth (feet) <u>210 feet</u>			
(3) static water level (feet) <u>140</u> below top of ground.			
(4) casing <u>PVC</u> , <u>210 feet</u> (material) (depth)			
(size) if telescope see back.			
(5) screen <u>6 ft.</u> , <u>204 feet</u> (length) (depth to top)			
<u>4"</u> , <u>gravel wall</u> (size) (material)			
(6) pump <u>3/4</u> , <u>10</u> (HP) (yield gpm)			
(type power)			
(7) electric log <u>Elect.</u> (yes or no)			
(organization running log)			
(8) how well bottom plugged <u>4" cap.</u>			
DRILLERS REMARKS:			

CODED

MAY 10 1971

MISS. BD. OF WATER COMMISSIONERS