

MARSHALL

J5
8-14-61

WATER WELL DRILLERS LOG

CODED

Date: 8-14, 1961, Driller: Adams Bros Co Inc County Marshall

(Name)

(1) Rabbit Alvin Warren Sr
Owner of Land:
(Name)

Byhalia Rte. 3 Box 24
(Address)

(2) Location: 33 35 40
1/4, 1/4, Sec. T R

 miles of ,
(distance) (direction) (Nearest Town)

(3) Topography:
(Hilly) (Flat) (Level)

(4) Purpose of Well:
(Domestic Irrigation
Municipal, Industrial, Other)

Description & Color of Materials
Sand, Clay, Red Clay, Shell, etc.

	Thickness Feet	Depth Feet
<u>top soil</u>	<u>0-20</u>	<u> </u>
<u>coarse red sand</u>	<u>20-80</u>	<u> </u>
<u>fine sand & clay</u>	<u>80-140</u>	<u> </u>
<u>coarse white sand</u>	<u>140-170</u>	<u> </u>

Information upon completion of well:

(1) Diameter 4 inches.

(2) Total Depth 170 feet.

(3) Water Level 120 feet below top of ground.

(4) Cased to 156, Size

(5) Screen: Size 4", Length 14'


(6) Were any formations sealed against pollution?
 yes, no.

If YES depth of formation

Why

Drillers Remarks:

CODED

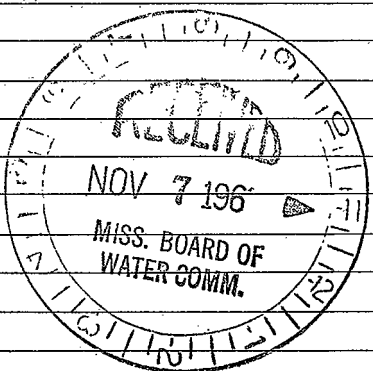

(Use Back Side)

Well No.

