

CODED

Marshall
J 13,
12-18-68

MISSISSIPPI
BOARD OF WATER COMMISSIONERS
416 North State Street
Jackson, Mississippi 39201

WATER WELL DRILLERS LOG

CODED

12-18 1968 Bob Smith Marshall
date well completed firm name county well located

LANDOWNER: Davis

description of formations encountered from to

Bygdin, Miss
(mailing address)

top soil 0 4
red clay 4 10
white clay 10 30
blue clay 30 100
white sand 100 152

WELL LOCATION:
sec. 8 T. 3 N. R. 4 E.
5 miles SE of Bygdin
(distance) (direction) (nearest town)

WELL PURPOSE: None
(home, irrigation, municipal, industrial)

WELL COMPLETION DATA:

- (1) diameter (inches) 4
- (2) total depth (feet) 152
- (3) static water level (feet) 100 below top of ground.
- (4) casing 4" plastic 152
(material) (depth)
(size) if telescope see back.
- (5) screen 20" 132
(length) (depth to top)
4" plastic
(size) (material)
- (6) pump 1/2 HP 10
(HP) (yield gpm)
- S. L. C.
(type power)
- (7) electric log No
(yes or no)

(organization running log)

(8) how well bottom plugged plugged

DRILLERS REMARKS:

good drilling

CODED

CODED

CODED


CODED

FEB 19 1969

MISS. Bd. OF
WATER CONTROL

If well telescopes please sketch and show depths.

GROUND LEVEL

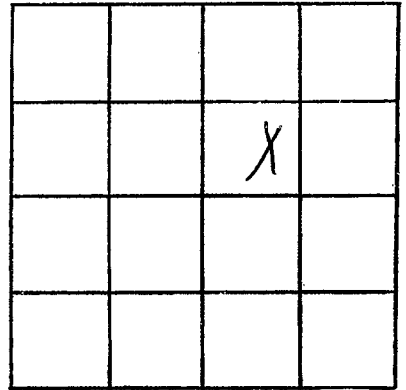

SECTION 8

Please indicate well location X.

ADDITIONAL INFORMATION

If more than one screen, show locations of each on sketch.