

Marshall  
 J 19  
 2-25-69

MISSISSIPPI  
 BOARD OF WATER COMMISSIONERS  
 416 North State Street  
 Jackson, Mississippi 39201

**CODED** CODED

WATER WELL DRILLERS LOG

Feb 25 1969 date well completed  
 Earl Jones Well Co. firm name  
 Marshall county well located

LANDOWNER: Lewis Jones  
 Byhalia Miss. R.F.P.  
 (mailing address)

description of formations encountered	from	to
Top soil & clay	0	17
sand	17	67
clay	67	135
sand	135	150
clay	150	165
sand	165	182

WELL LOCATION:  
 sec. 29 T 3 N R 4 E  
 3 S W  
 3 miles East of Watson  
 (distance) (direction) (nearest town)

WELL PURPOSE: HOME  
 (home, irrigation, municipal, industrial)

**CODED**

WELL COMPLETION DATA:

(1) diameter (inches) 2

(2) total depth (feet) 182

(3) static water level (feet) 100 below top of ground.

(4) casing plastic 176  
 (material) (depth)  
 (size) if telescope see back.

(5) screen 6 ft 176  
 (length) (depth to top)  
2 coarse plastic & gravel  
 (size) (material)

(6) pump 1 1/2 3 1/2  
 (HP) (yield gpm)  
electric  
 (type power)

(7) electric log no  
 (yes or no)  
 (organization running log)

(8) how well bottom plugged  
plastic cap

**CODED**


APR - 7 1969

MISS. Bd. of WATER COMMISSIONERS

DRILLERS REMARKS:

If well telescopes please sketch and show depths.

GROUND LEVEL

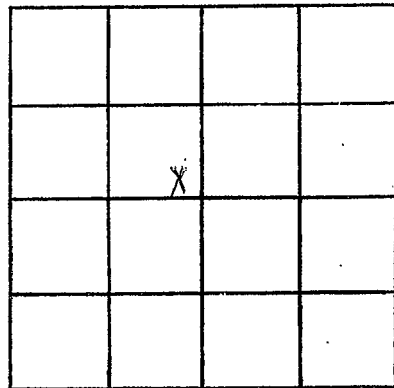

SECTION 29

Please indicate well location X.

ADDITIONAL INFORMATION

If more than one screen,  
show locations of each on sketch.