

Marshall
 8 15
 4-28-69

MISSISSIPPI
 BOARD OF WATER COMMISSIONERS
 416 North State Street
 Jackson, Mississippi 39201

CODED

WATER WELL DRILLERS LOG

April 28 1969 Earl Jones Well Co. Marshall
 date well completed firm name county well located

LANDOWNER:

Woodrow Conway
 Victoria Miss.
 (mailing address)

description of formations encountered

from to

Top soil and clay	0	15
sand	15	70
clay	70	75
sand	75	84
clay	84	90
sand	90	126

WELL LOCATION:

sec. 3 T. 3 N. R. 4 E. Victoria
 S W
 (distance) miles (direction) (nearest town)

WELL PURPOSE: Home
 (home, irrigation, municipal, industrial)

WELL COMPLETION DATA:

- (1) diameter (inches) 2
- (2) total depth (feet) 126
- (3) static water level (feet) 88 below above top of ground.
- (4) casing plastic 120 ft. (material) (depth)
 2" (size) If telescope see back.
- (5) screen 6' 120 ft. (length) (depth to top)
 2" (size) plastic-gravel (material)
- (6) pump 1 (HP) 4 (yield gpm)
 Electric (type power)
- (7) electric log no (yes or no)

CODED

(organization running log)

MAY 26 1969


(8) how well bottom plugged
 buckshot

MISS. BD. OF
 WATER COMML.

DRILLERS REMARKS:

If well telescopes please sketch and show depths.

GROUND LEVEL

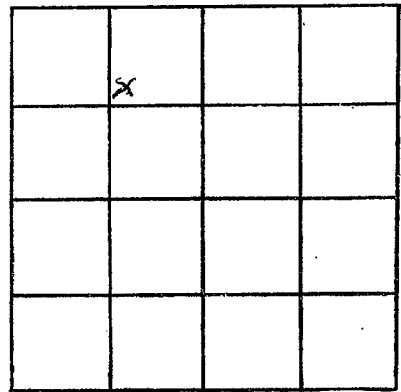

SECTION 3

Please indicate well location X.

ADDITIONAL INFORMATION

If more than one screen, show locations of each on sketch.